


# T. 7 S. R. 4 W. W. M.

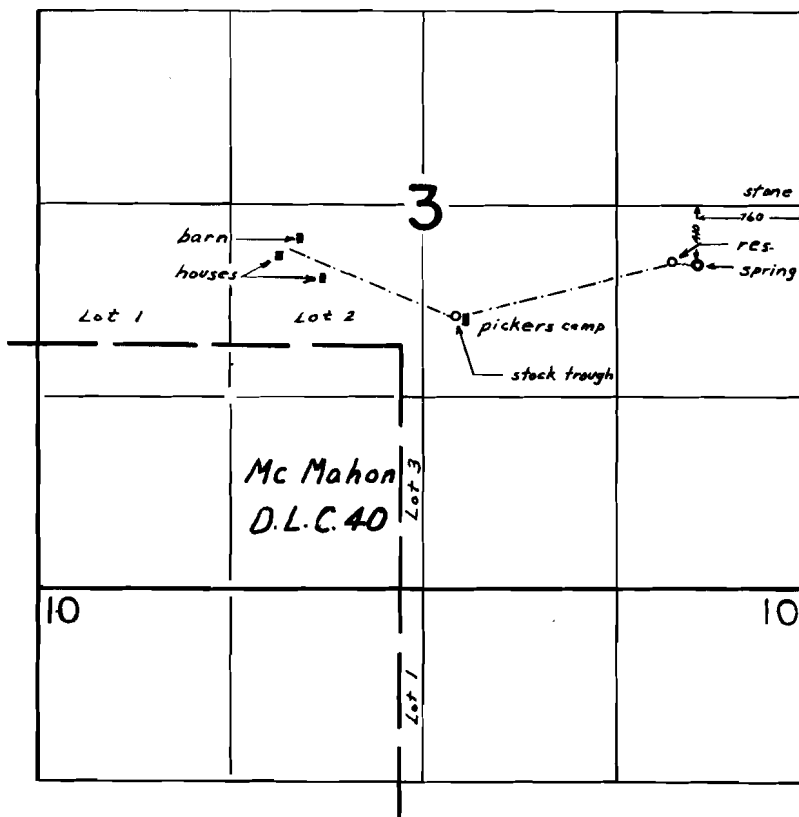

## FINAL PROOF SURVEY UNDER

Application No. 45644 Permit No. 34040  
IN NAME OF

FREEMAN LAND & LIVESTOCK CO.

Surveyed Nov. 21, 1968, by B. Mucken