


T.3N.R.29E.W.M.

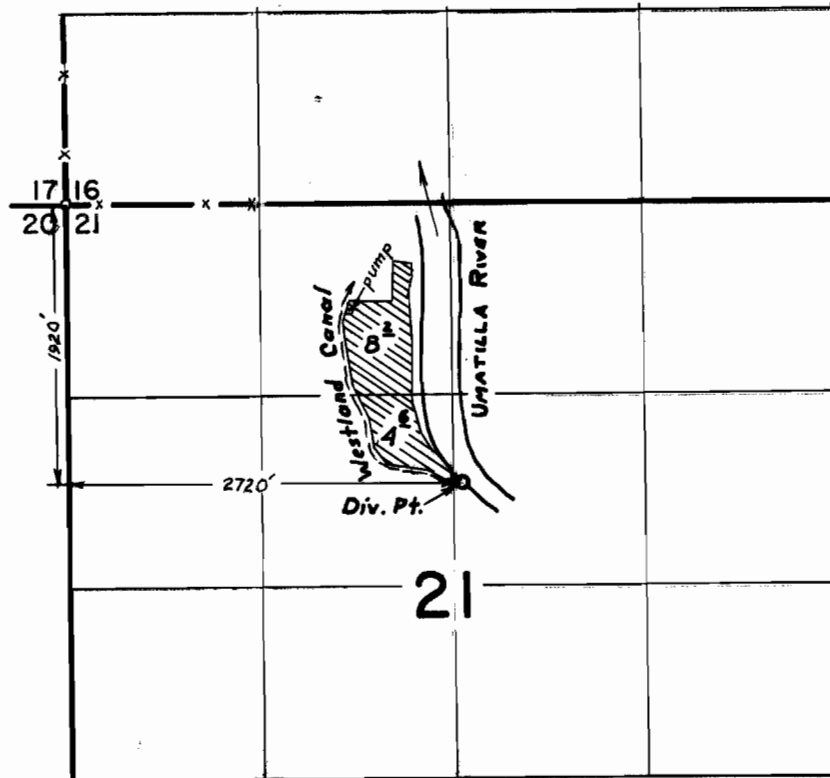

FINAL PROOF SURVEY UNDER

Application No. 38804 Permit No. 30014
IN NAME OF

SPIKE BROS.

Surveyed Jul. 9 1969, by L. E. Gould