


T.5 N., R.27 E.W.M.

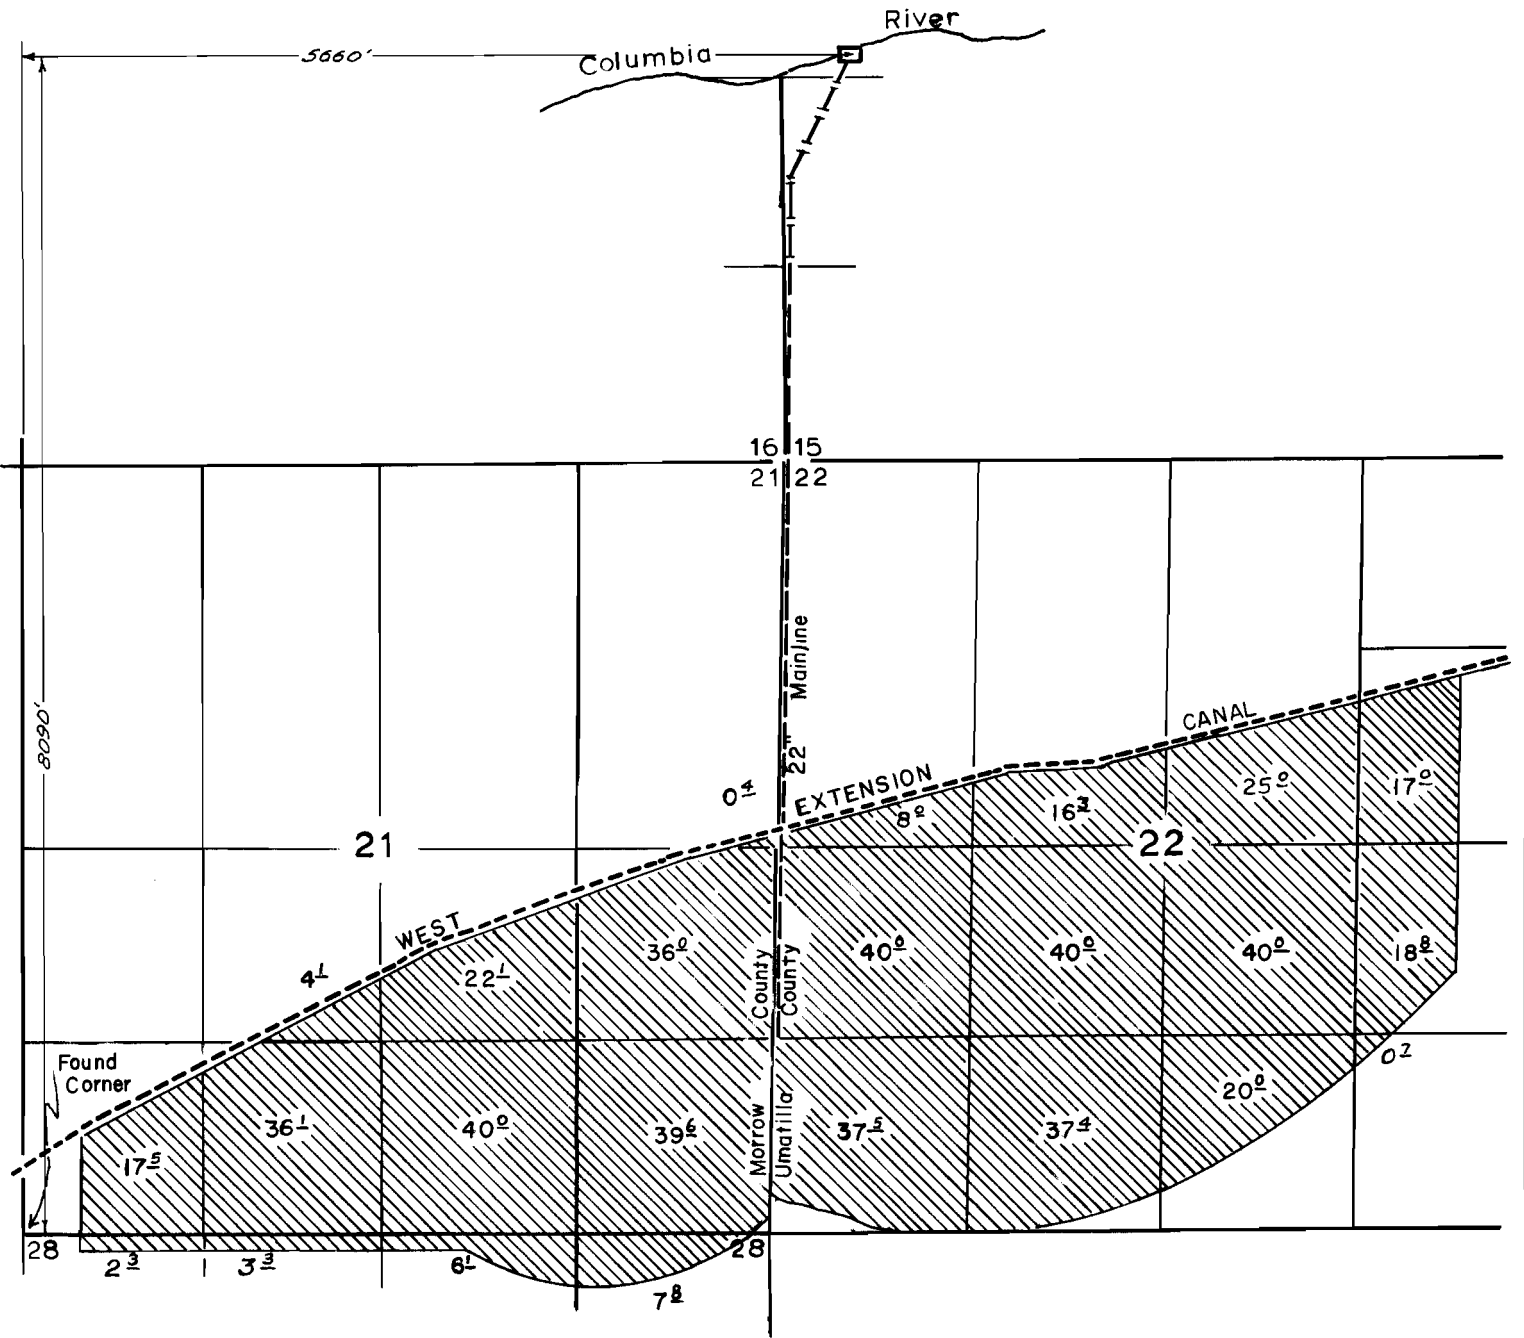

FINAL PROOF SURVEY UNDER

Application No. 42846 Permit No. 31346
IN NAME OF

Raymond Dunn & William McClannahan

Surveyed 11-25 1969, by J.F. Haines