


T. I. S. R. 39 E. W. M.

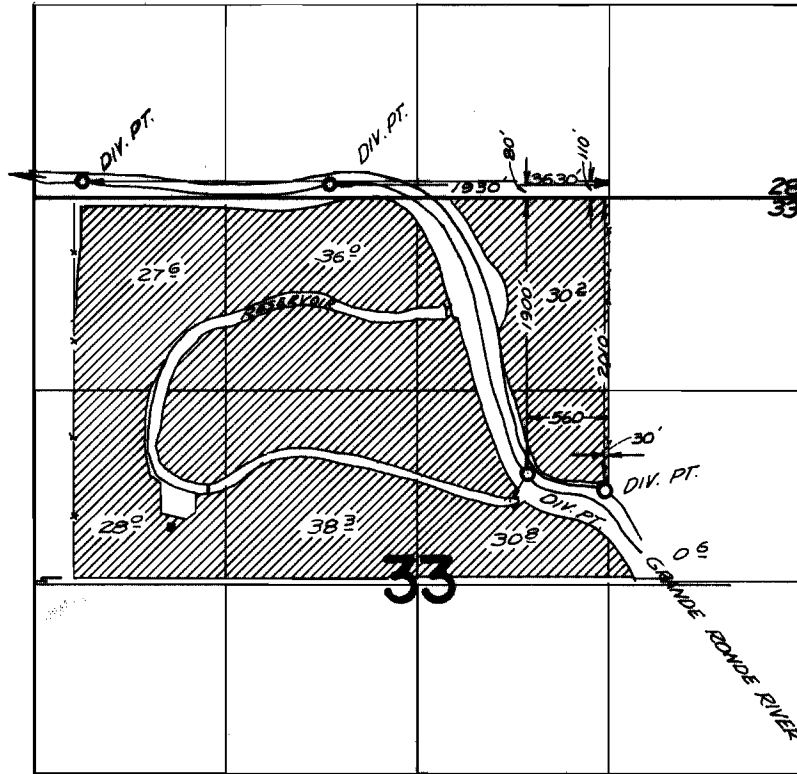

FINAL PROOF SURVEY UNDER

38175 28920
Application No. R-38317 Permit No. R-3412
IN NAME OF

ARMOND J. ARNOLDUS

Surveyed Aug 21, 1968, by V. Garner