


T. I S. R. 39 E. W. M.

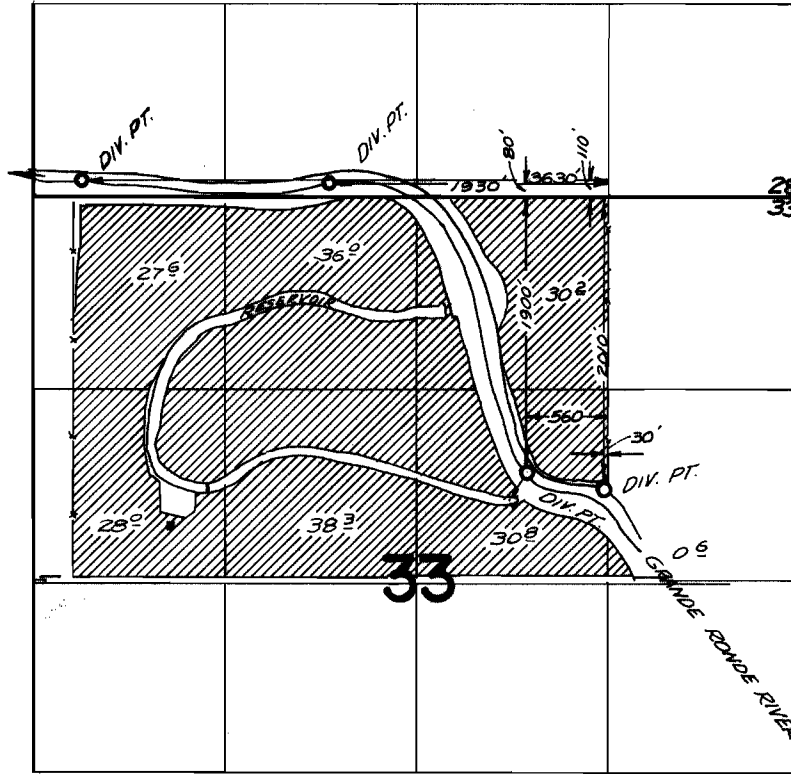

FINAL PROOF SURVEY UNDER

38175 28920
Application No. *R-38317* Permit No. *R-3412*
IN NAME OF

ARMOND J. ARNOLDUS

Surveyed *Aug 21, 1968*, by *V. Garner*