


T. 3 S. R. 40 E. W.M.

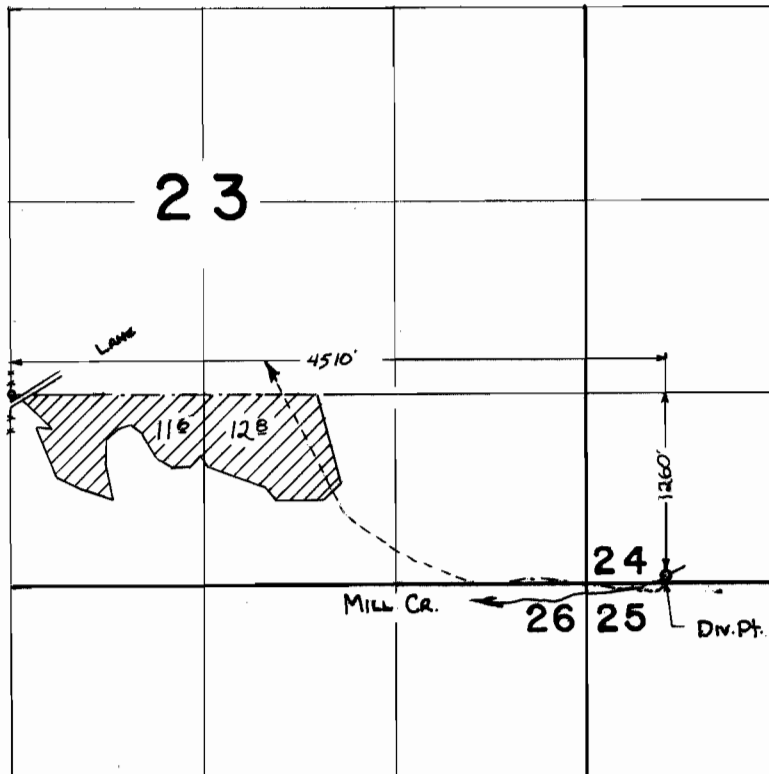

FINAL PROOF SURVEY
UNDER

Application No. 38538 Permit No. 28723
IN NAME OF

FRANK L. NIMS

Surveyed 24 JULY 1969, by W. J. RUPPERT