


# T.I.S.R.39E.W.M.

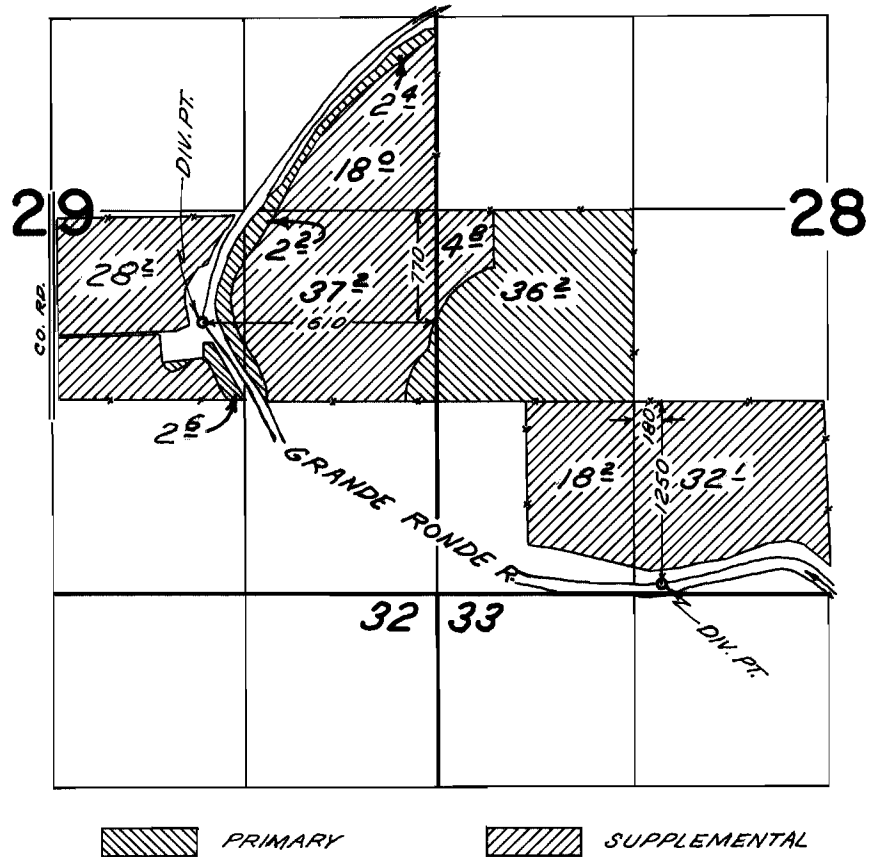

## FINAL PROOF SURVEY UNDER

Application No. 38621 Permit No. 28751  
IN NAME OF

OSCAR W. HOWELL

Surveyed AUG 21 1968, by V. GARNER