




# T. 2 N. R. 39 E. W.M.

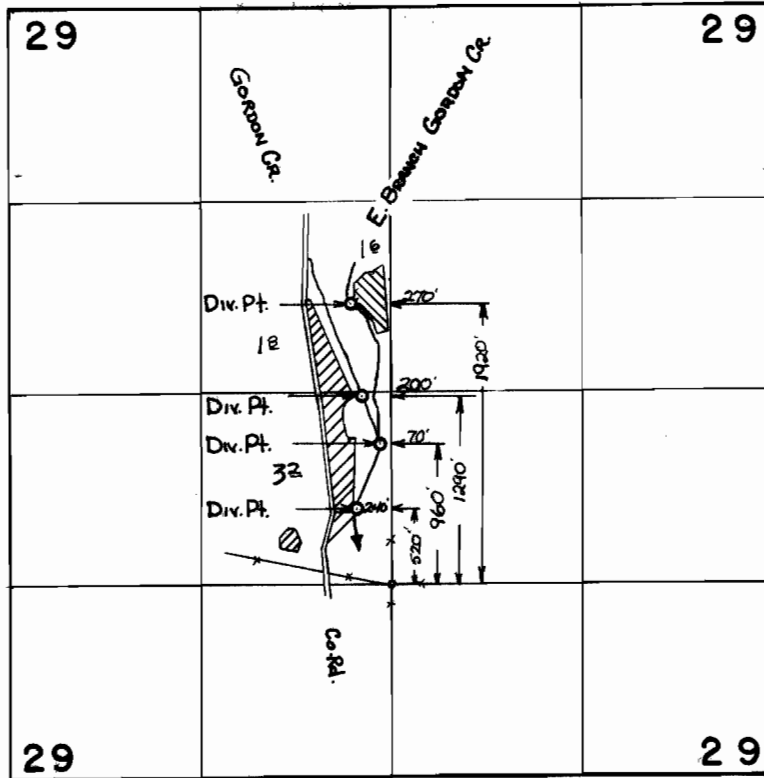

 GORDON CR.  
 E. BRANCH GORDON CR.

## FINAL PROOF SURVEY UNDER

Application No. 38362 Permit No. 28790  
IN NAME OF

THEODORE T. FORTH

Surveyed 18 JULY 1969, by W. J. RUPPERT