


T. 1 N. R. 39 E. W. M.

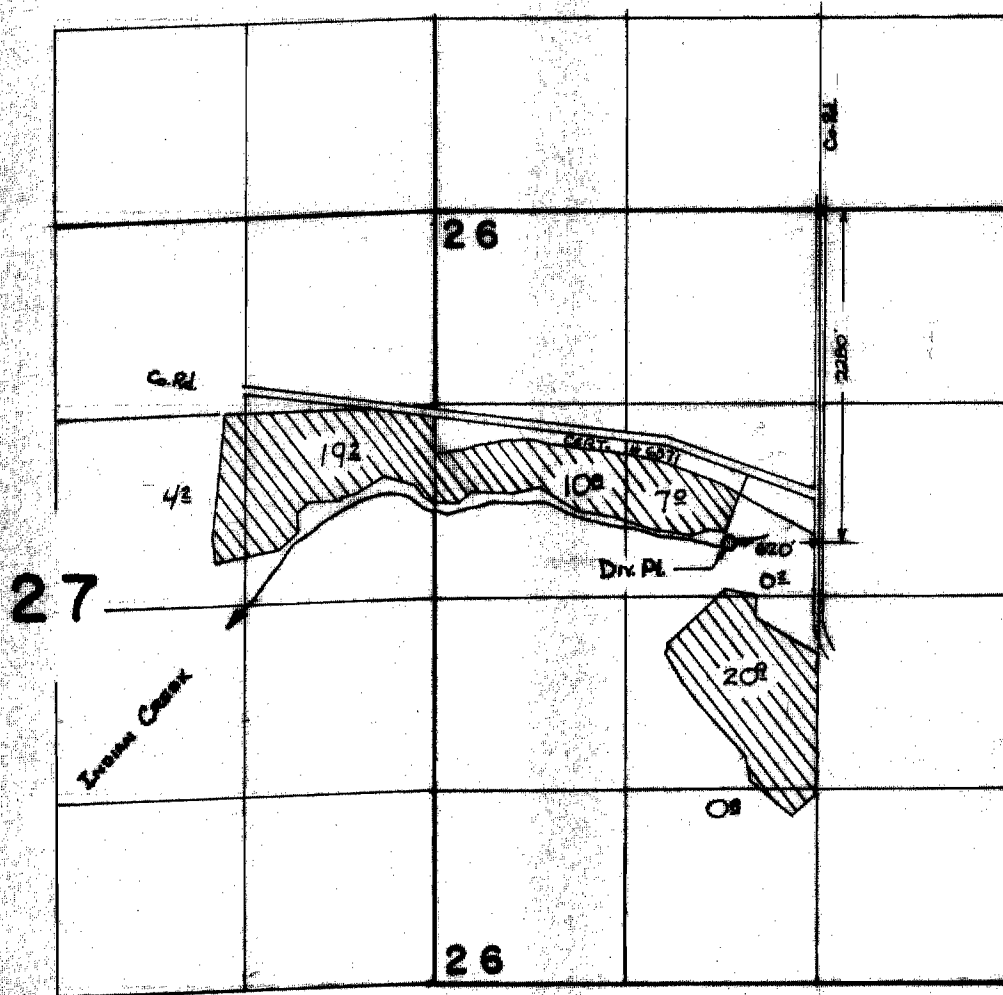

**FINAL PROOF SURVEY**  
UNDER

Application No. 37667... Permit No. 28179...  
IN NAME OF

**DELMER J. GALLOWAY**

Surveyed 18 JULY 1969, by W. J. RUPPERT.