


T. 3 S. R. 40 E. W.M.

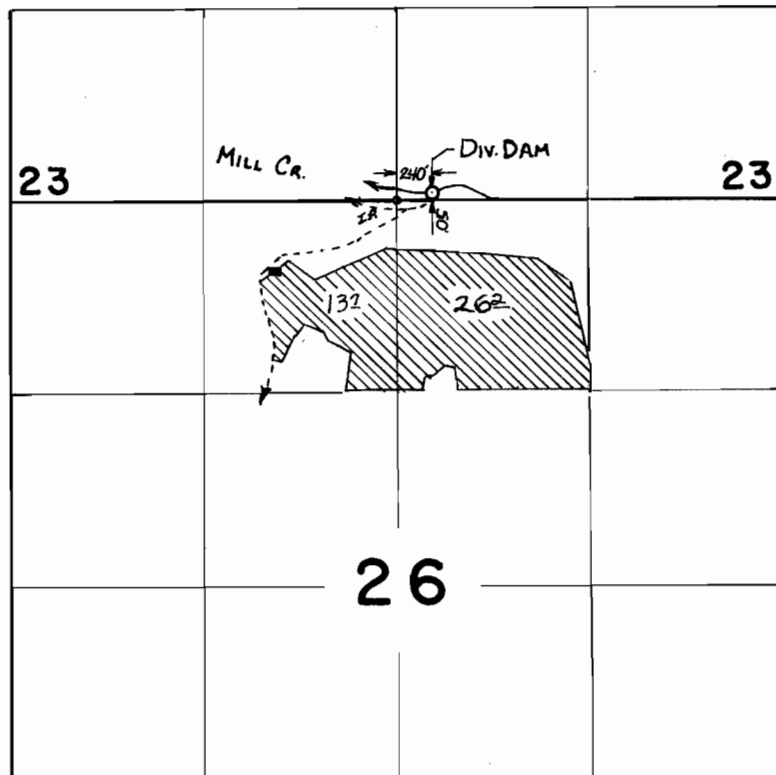

FINAL PROOF SURVEY
UNDER

Application No. 40486... Permit No. 30169...
IN NAME OF

CLIFFORD TOWLE

Surveyed 24 JULY 1969, by W. J. RUPPERT.