


T. 1 S. R. 39 E. W. M.

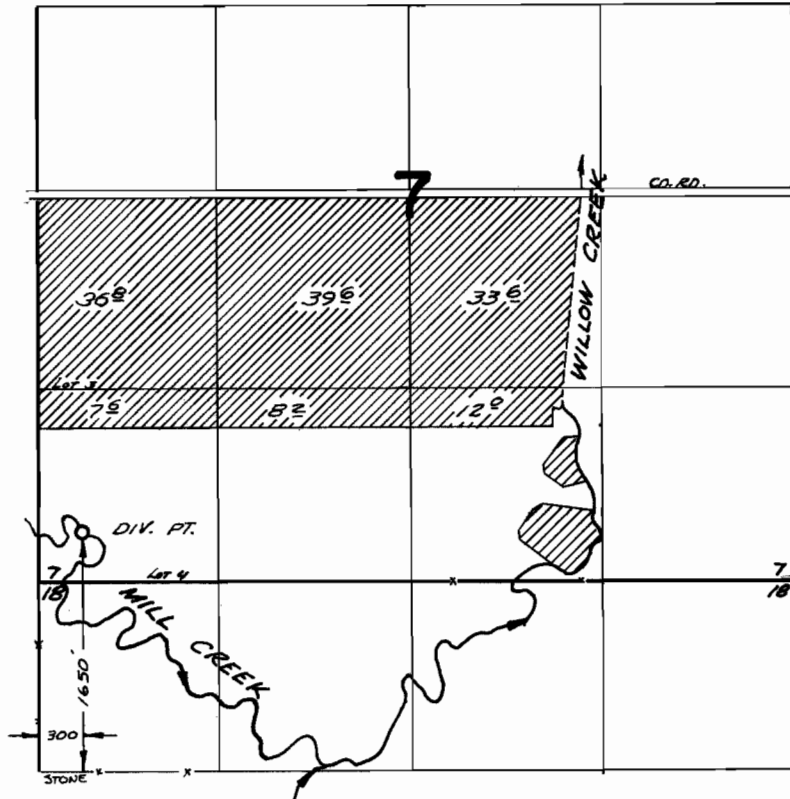

FINAL PROOF SURVEY UNDER

Application No. 40544 Permit No. 30374
IN NAME OF

MYRON G. HUG

Surveyed Aug 24 1968, by V. Garner