


T. 1 S. R. 38 E. W. M.

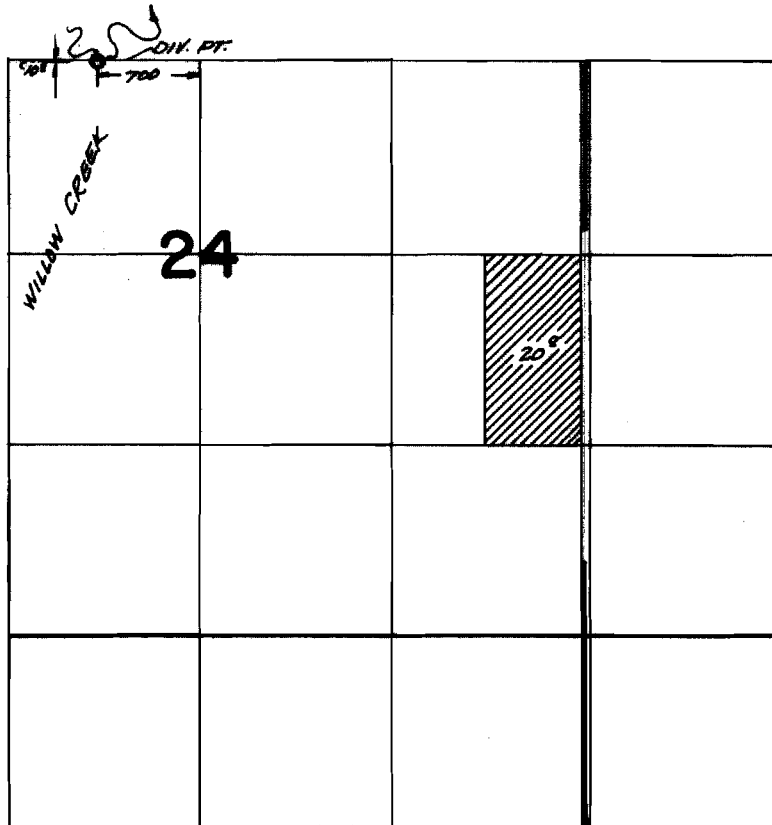

FINAL PROOF SURVEY UNDER

Application No. 41543 Permit No. 30989
IN NAME OF

ALFRED A. and BONNIE J. ARNOLDUS

Surveyed Aug. 23 1968, by V. Garner