


T. 1 N. & 1 S. R. 39 E. W.M.

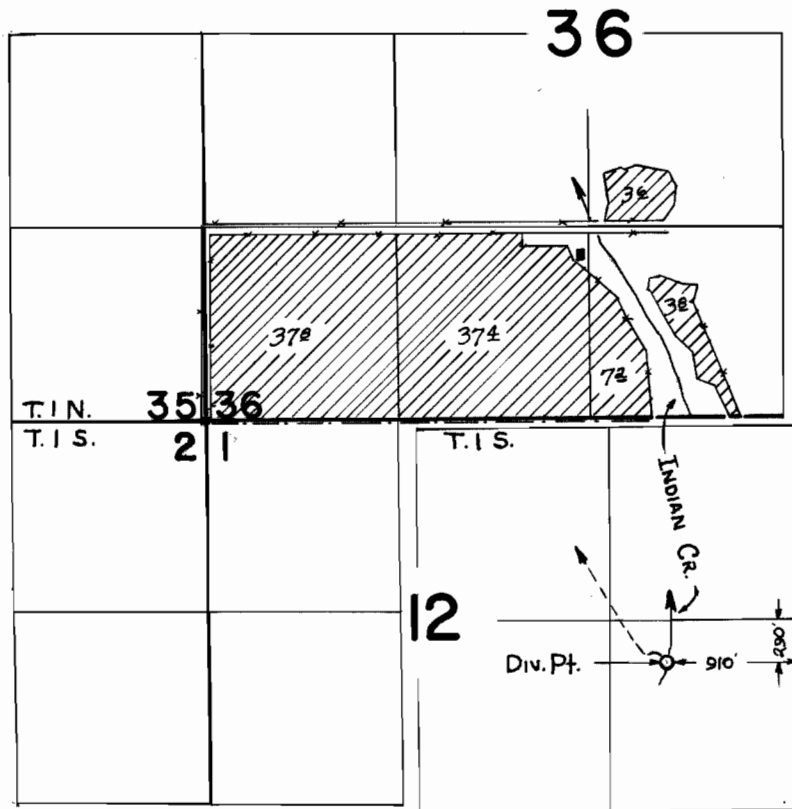

FINAL PROOF SURVEY UNDER

Application No. 41599..... Permit No. 31027.....
IN NAME OF

.....**SPENCER TOLLEY**.....

Surveyed 22 JULY 1969, by W. J. RUPPERT