


# T. 1 N. R. 39 E. W.M.

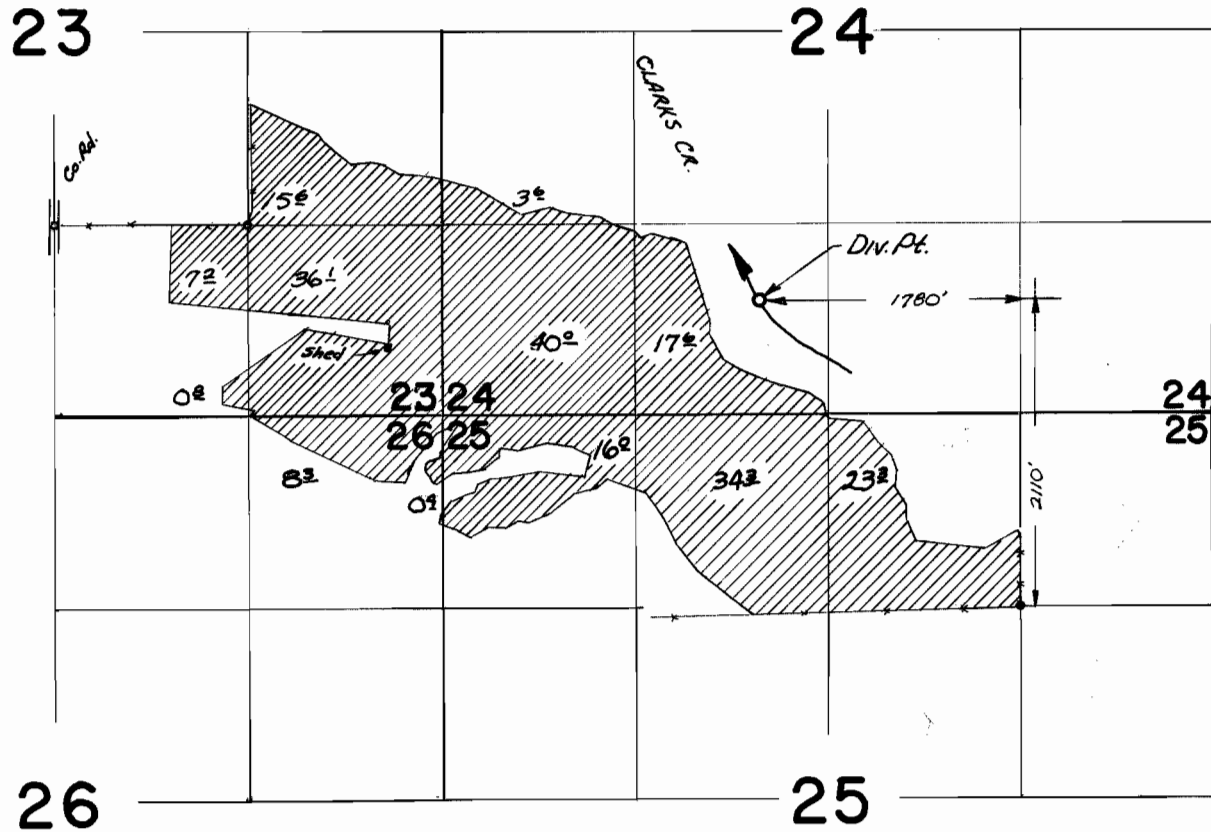

## FINAL PROOF SURVEY UNDER

TRANSFER W 114  
 Application No. 41782 Permit No. 31186  
 IN NAME OF

PETER C. WESTENSKOW

Surveyed 28 AUG. 1969, by W. J. RUPPERT