


T.1N.R.39E.W.M.

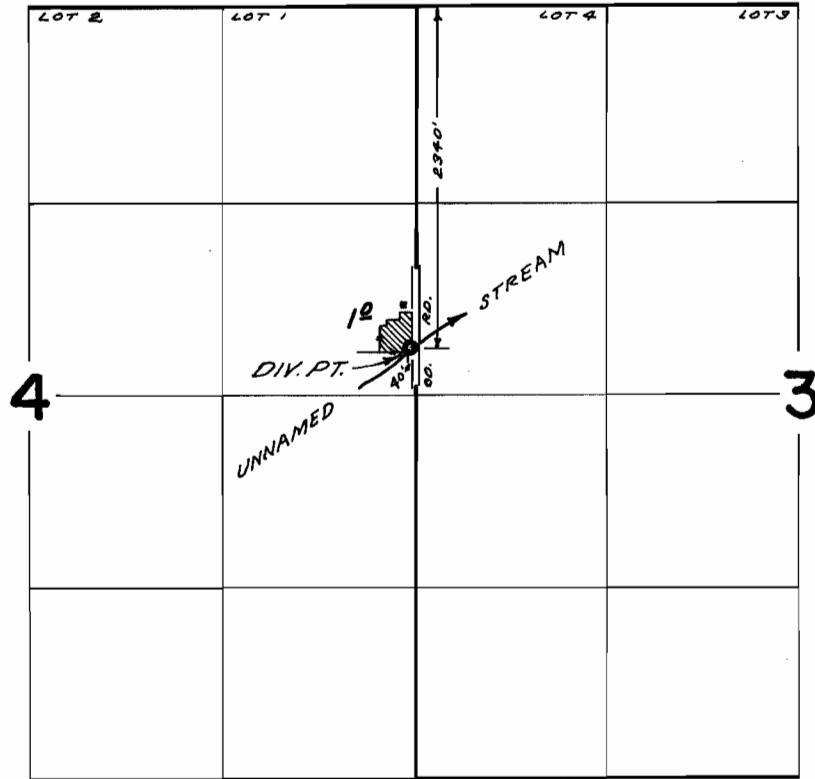

FINAL PROOF SURVEY UNDER

Application No. 42339 Permit No. 31653
IN NAME OF

GLENN AND WANDA DOUD

Surveyed AUG. 28 1968, by V. GARNER