


T. 1 S. R. 38 E. W.M. . .

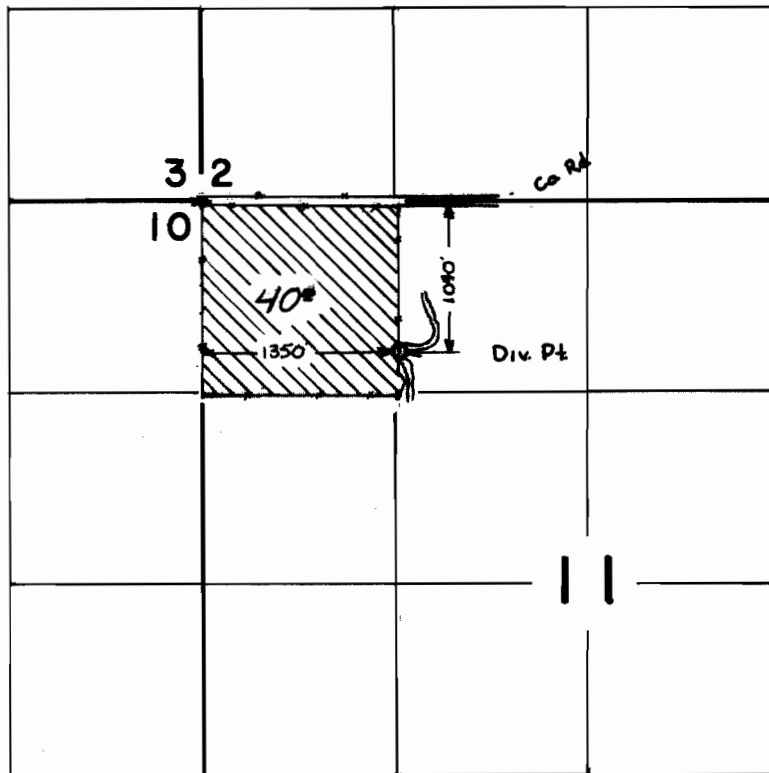

FINAL PROOF SURVEY
UNDER

Application No. 42609 Permit No. 31831
IN NAME OF

DILLARD R. CHOATE

Surveyed 15 JULY 1969, by W. J. RUPPERT