


T. 3 S. R. 40 E. W.M.

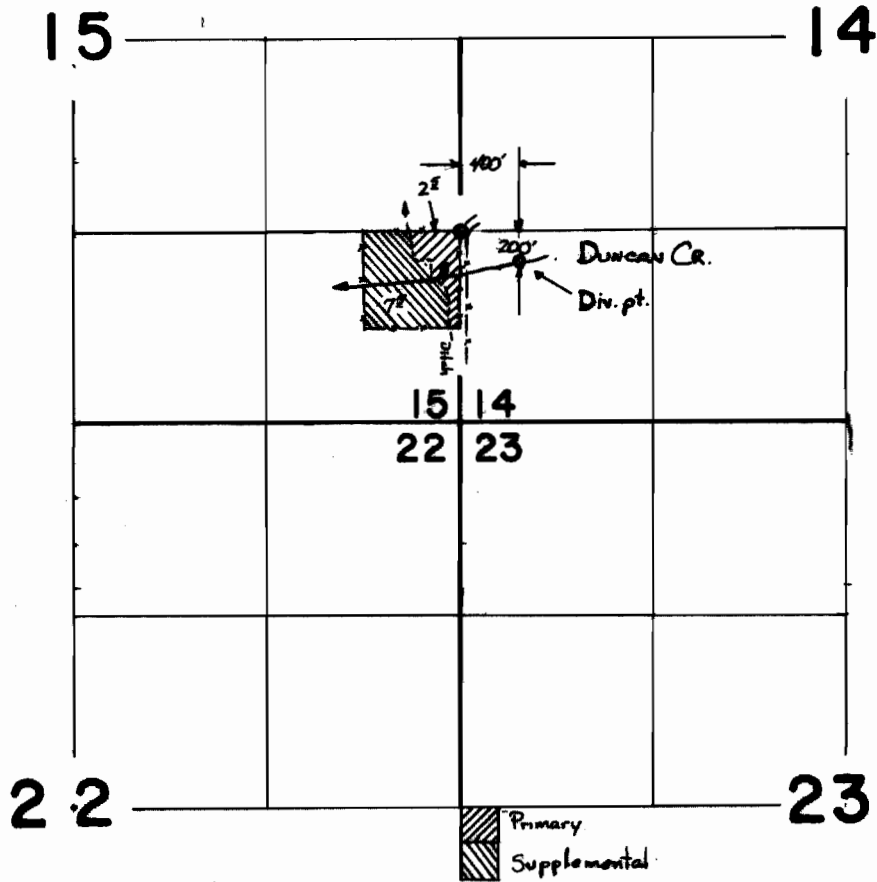

FINAL PROOF SURVEY
UNDER

Application No. 42724 Permit No. 32208
IN NAME OF

ARTHUR L. STOCKTON

Surveyed 24 JULY 1969, by WILLIAM J. RUPPERT