


T9S. R.21E. W.M.

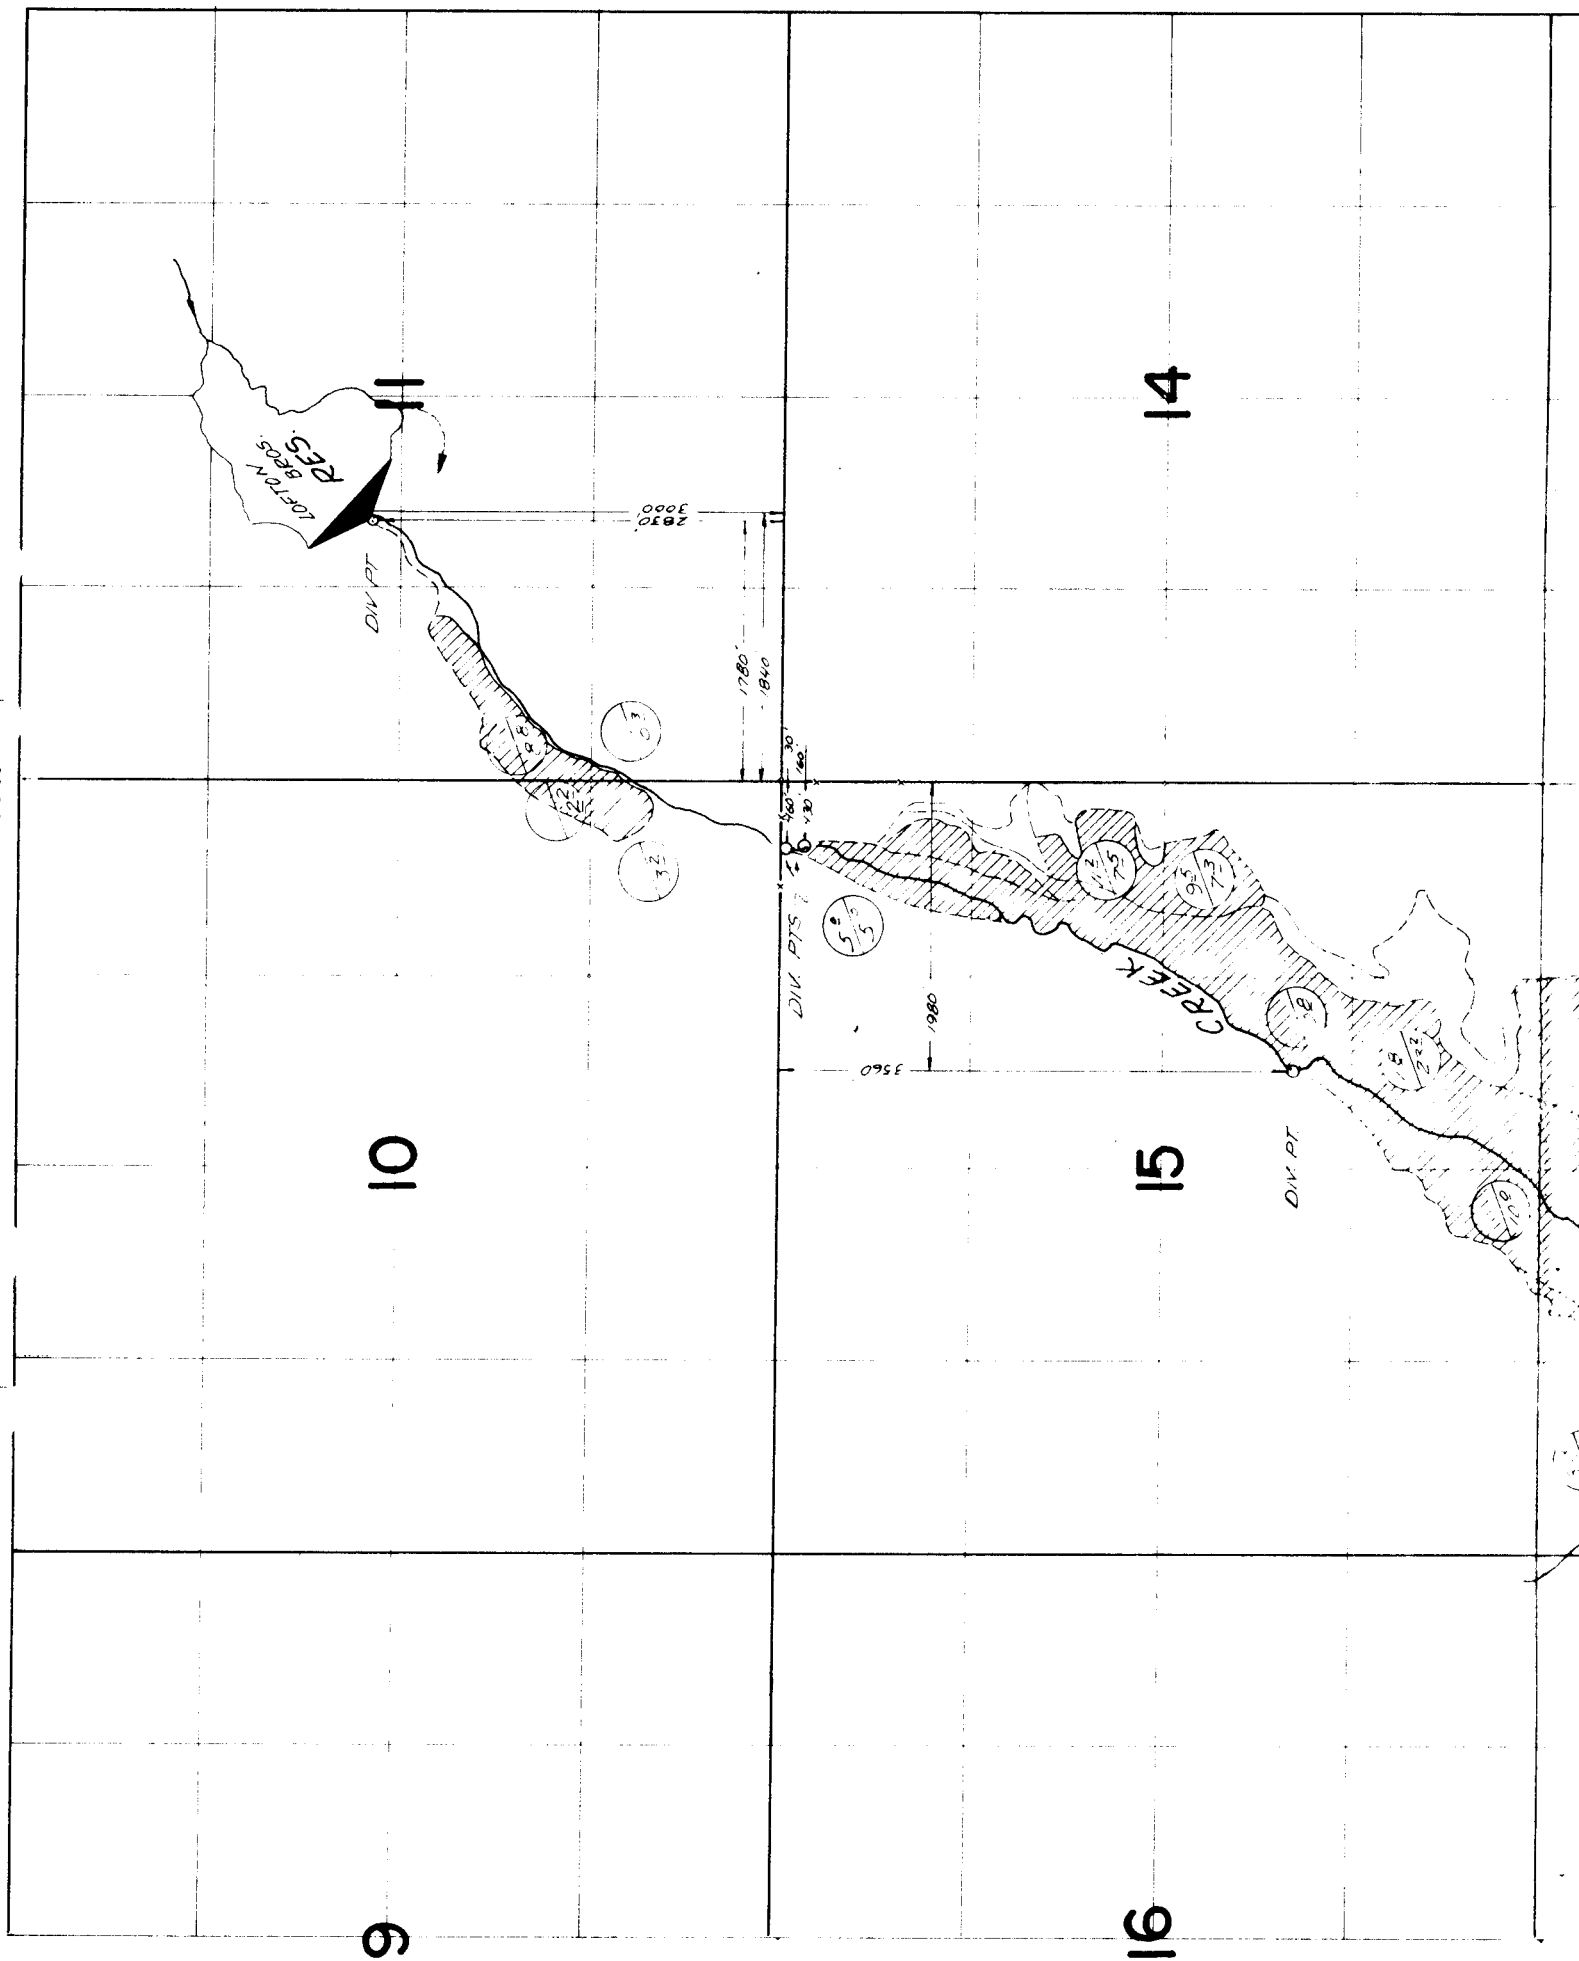

22

32

PRIMARY SUPPLEMENTAL

FINAL PROOF SURVEY

UNDER

APPLICATION NO. R-22424 PERMIT NO. R-930
22425 18275

IN NAME OF

ROWE CREEK RANCH, INC.

SURVEYED APRIL 19, 1955
SURVEYED MAY 23, 1968

BY: T. JONES
BY: V. GARNER

00V-104 51
00V-104 53
00V-104 94
1968 5

2

22