


P 28867
36702

T.9 S. R.21 E. W.M.

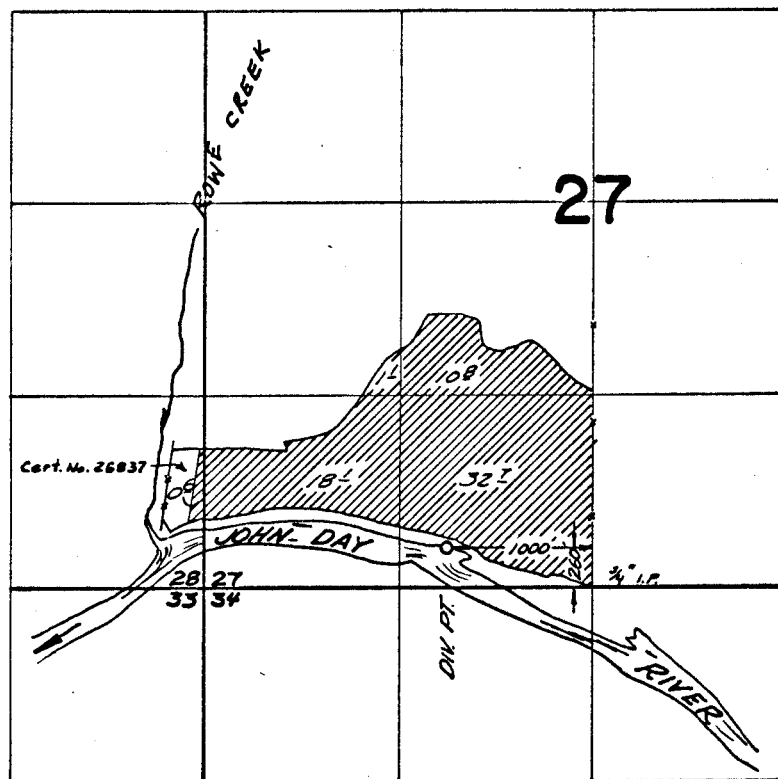

FINAL PROOF SURVEY
UNDER

Application No. 38869... Permit No. 28867...
IN NAME OF

ROWE CREEK RANCHES, INC.

Surveyed July 11, 1968, by V. Gerner

1968-C