


P 30542
36703

T.9 S. R.21 E. W.M.

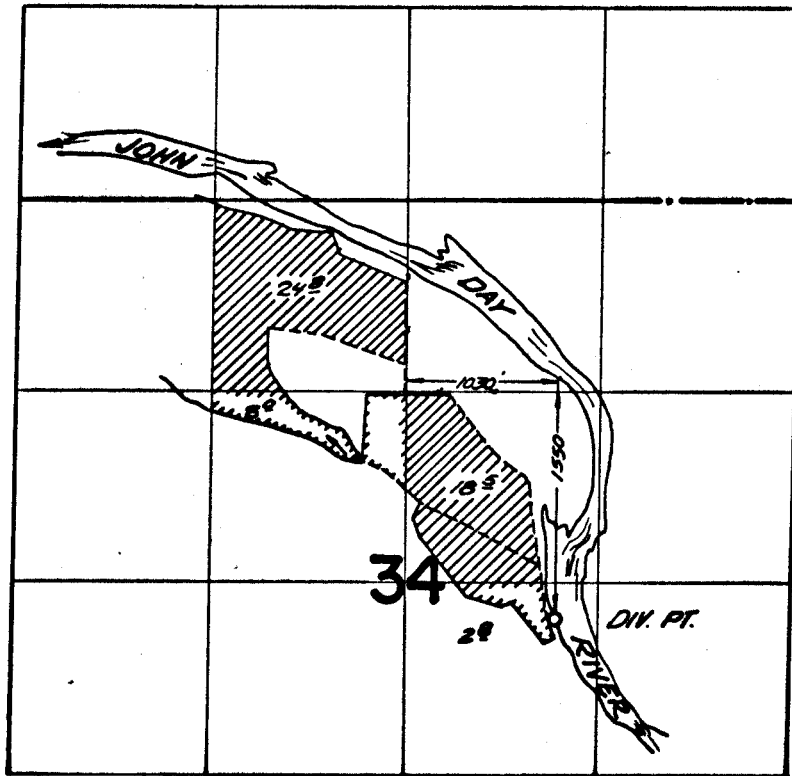

FINAL PROOF SURVEY
UNDER

Application No. 40954... Permit No. 30542...
IN NAME OF

VIRGIL MISENER

Surveyed July 11, 1968, by V. Garner