


T. 7S. R. 5W. W.M.

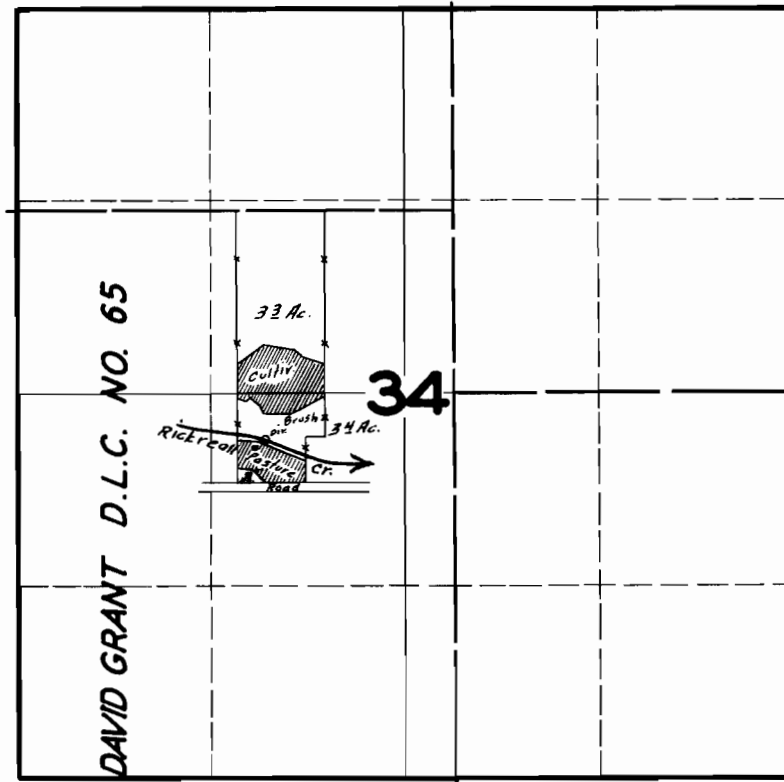

FINAL PROOF SURVEY
UNDER

Application No. 17366 Permit No. 13071

IN NAME OF

JOHN A. INGLIS

Surveyed AUG. 13, 1945, by *[Signature]*