


T. 7S. R. 5W.W.M.

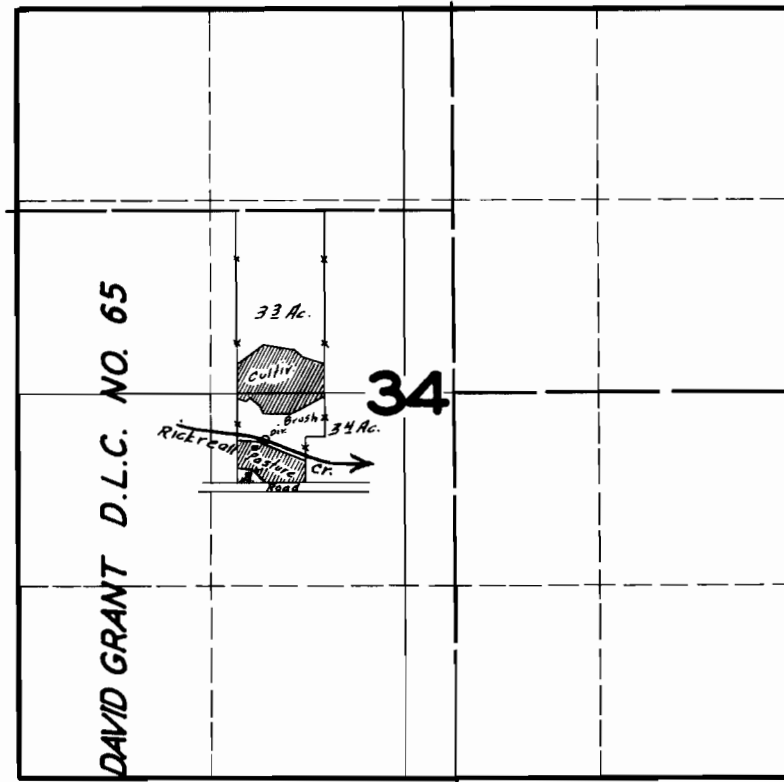

FINAL PROOF SURVEY UNDER

Application No. 17366 Permit No. 13071

IN NAME OF
JOHN A. INGLIS

Surveyed AUG. 13, 1945, by *[Signature]*