


T. 2 S. R. 1 & 2 W. W. M.

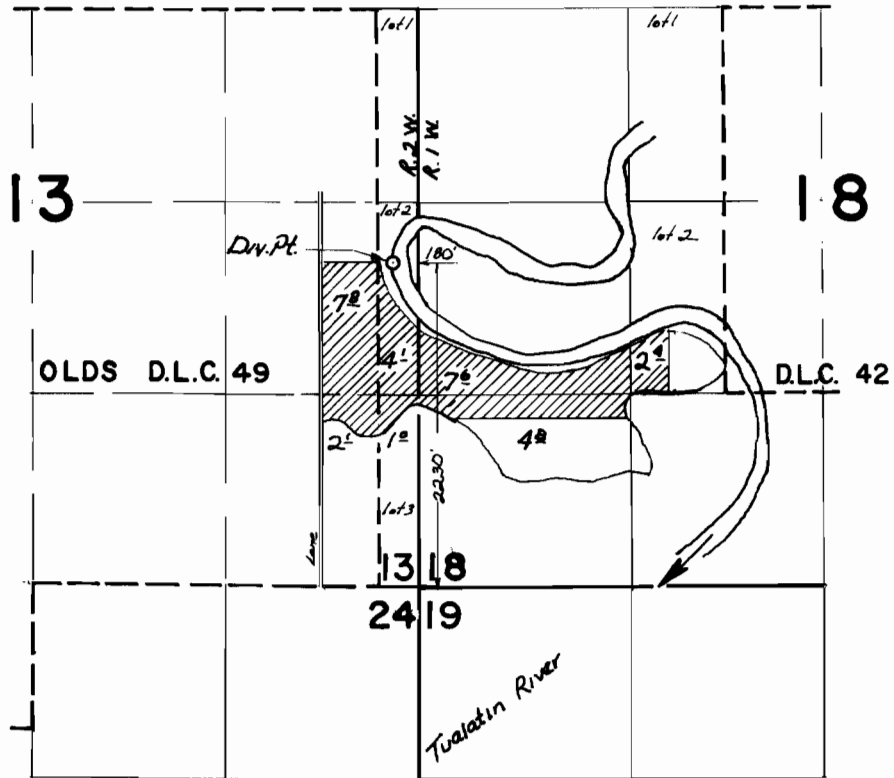

FINAL PROOF SURVEY
UNDER

Application No. 29933 Permit No. 23584
IN NAME OF

DAVID A. JOHNSTON

Surveyed 24 JUNE 1960, by R.H. JACKSON