


T.IIS.R43E.W.M.

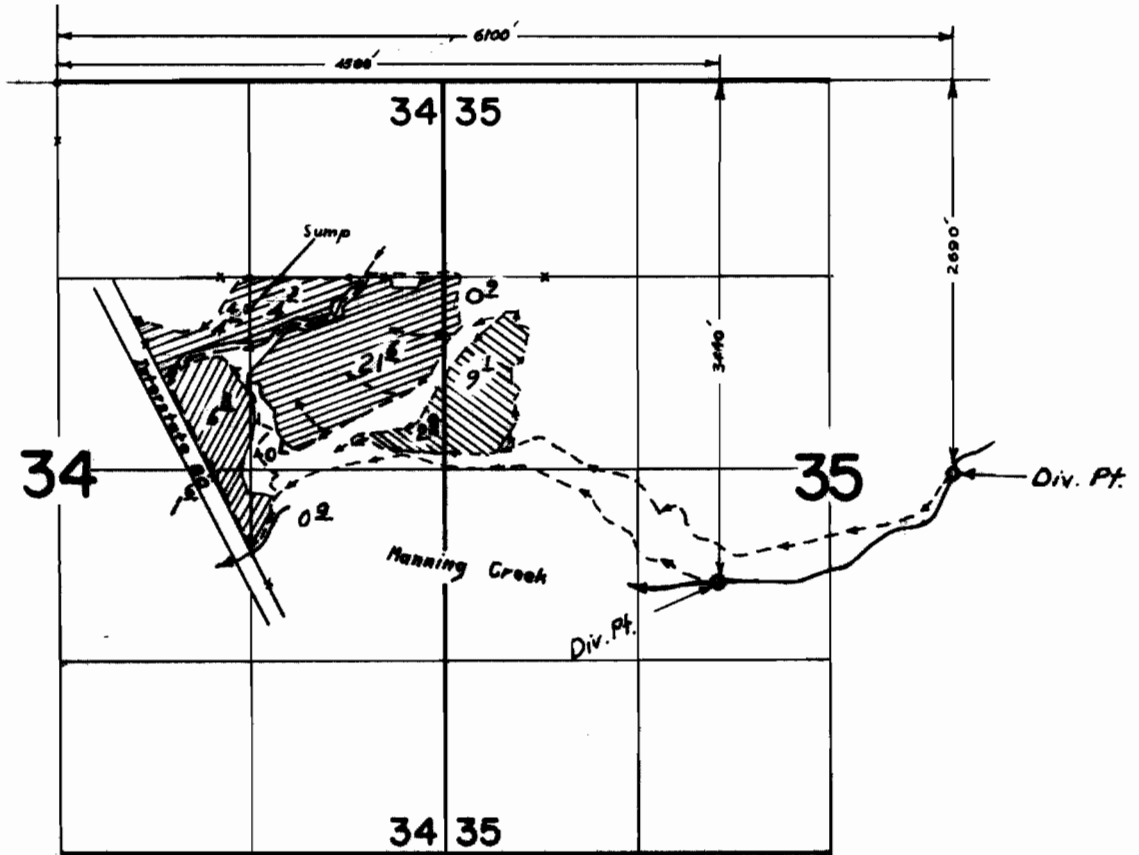

FINAL PROOF SURVEY UNDER

Transfer No. B-148
40297
41359

30056
30895



Application No. 43207... Permit No. 32301...

IN NAME OF

EARL SUITTER

Surveyed Oct. 18, 1969, by L. E. Gould