






T.11S.R43E.W.M.

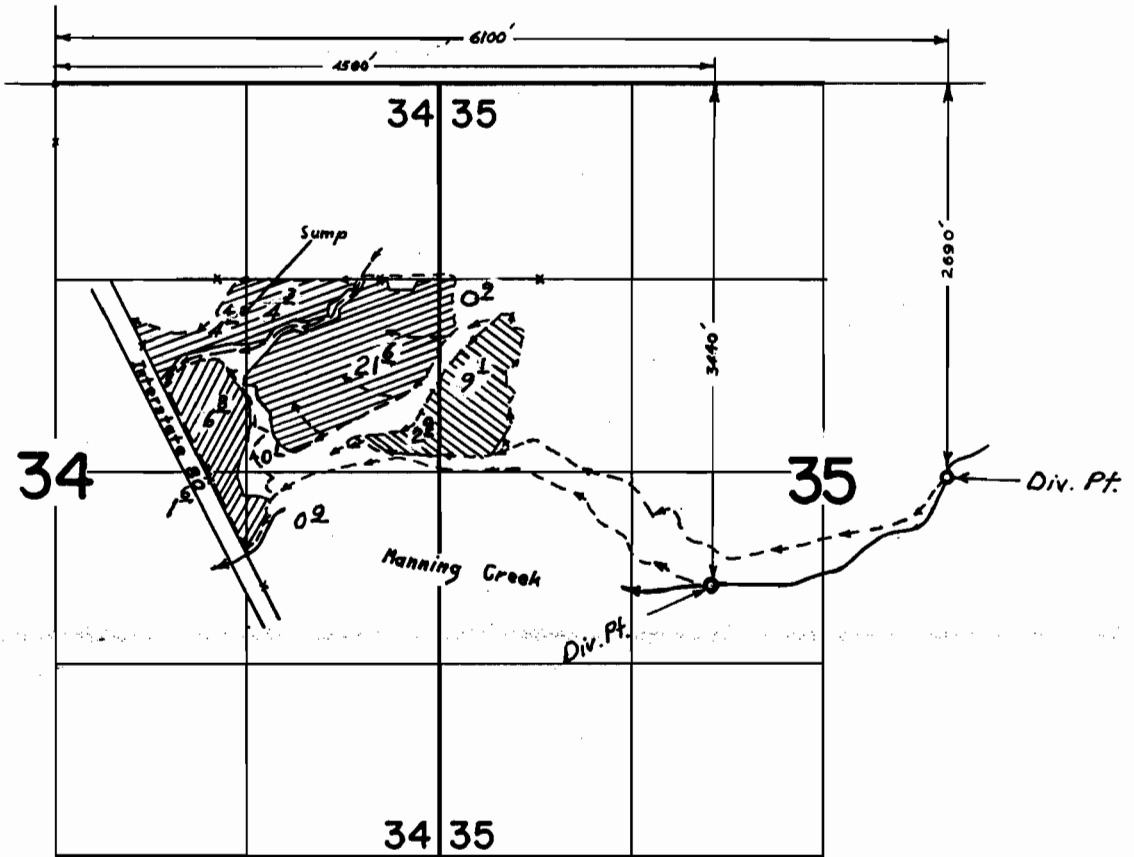

FINAL PROOF SURVEY UNDER

Transfer No. B-148		
40297	30056	
41359	30895	
Application No. 43207	Permit No. 32301	

IN NAME OF

EARL SUITTER

Surveyed Oct. 18, 1969, by L. E. Gould