


T.I.S.R.4W.W.M.

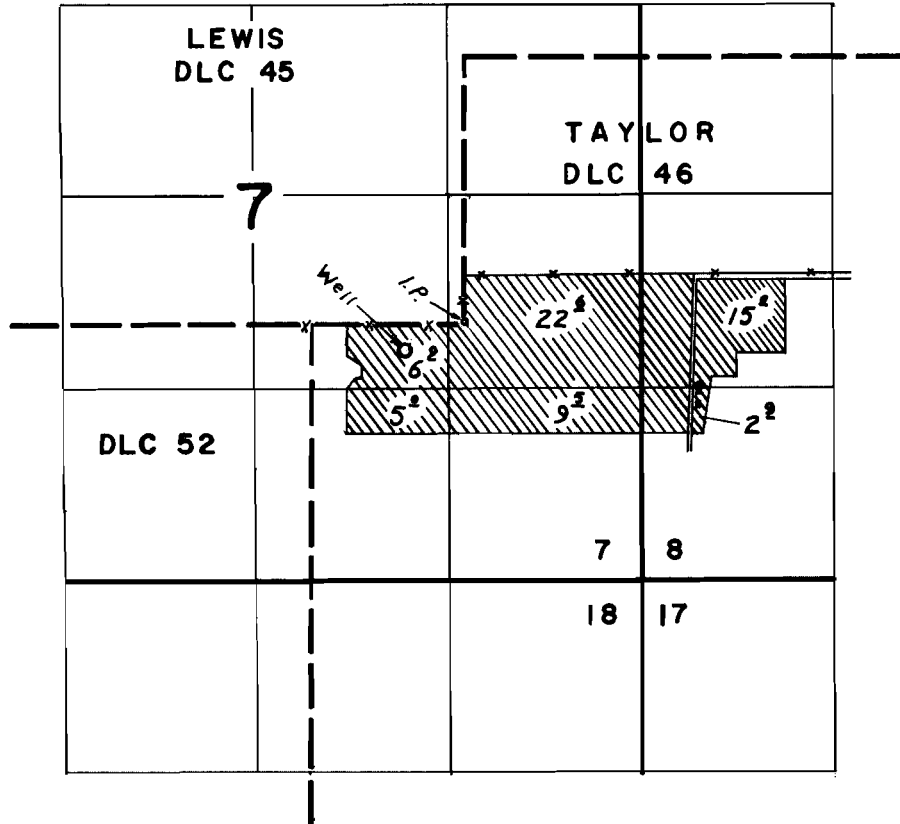

Div. Pt. located: 180 ft. S. & 410 ft. W. from most Southerly S.E. cor. DLC 45.

FINAL PROOF SURVEY UNDER

Application No. G-2764. Permit No. G-2567.
IN NAME OF
AGRICULTURAL ENGINEERING DEPARTMENT,
OREGON STATE UNIVERSITY

Surveyed May 28, 1969, by L. E. Gould.