


T. 13 & 14 S. R. 5 W. W.M.

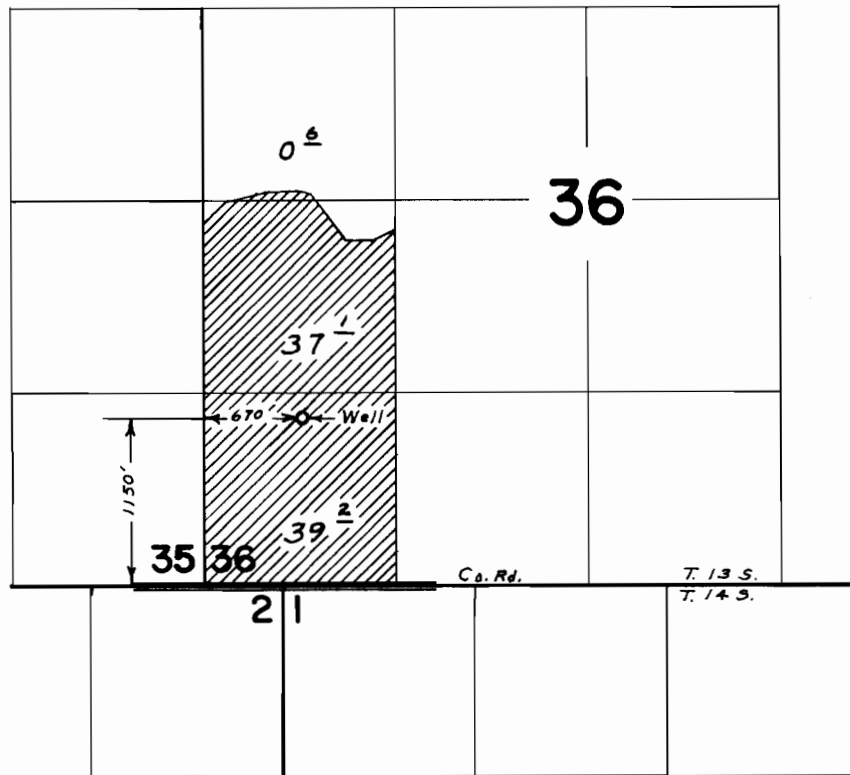

FINAL PROOF SURVEY
UNDER

Application No. G-3500 Permit No. G-3297
IN NAME OF

CHRIS C. & ELIZABETH JEAN LINDSETH

Surveyed Oct. 31, 1969, by L. E. Gould