


T.12S.R5W.W.M.

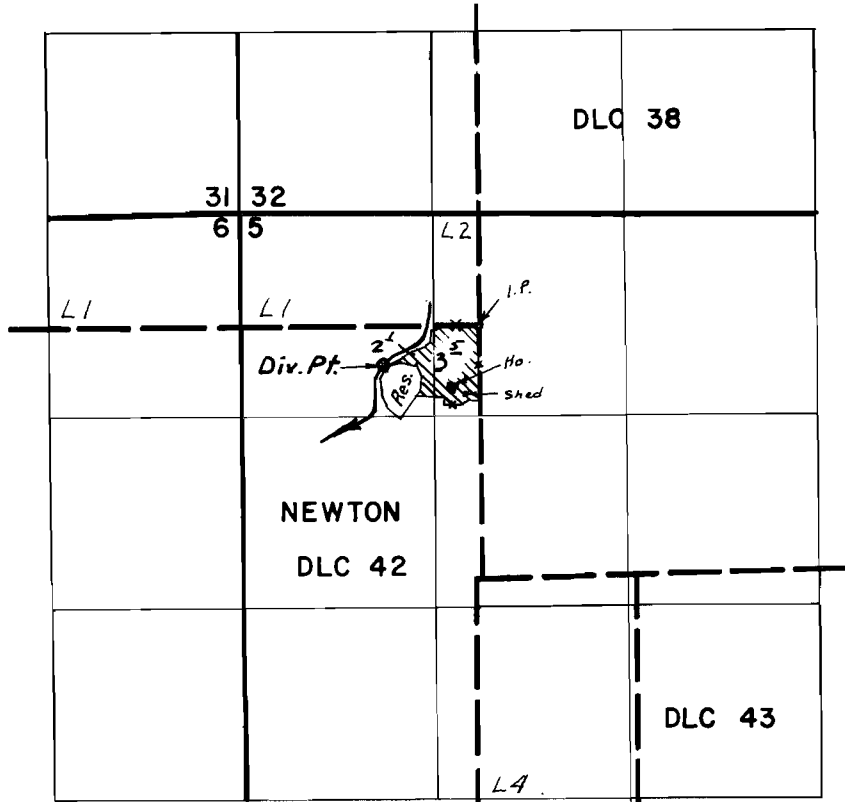

Div. Pt. located: 270 ft. S. & 660 ft. W. from NE cor. Newton DLC 42.

**FINAL PROOF SURVEY**  
UNDER

Application No. R-38080 38081 Permit No. R-3205 28556  
IN NAME OF

**FRANK G. HORVATH**

Surveyed Jul. 2, 1969, by L. E. Gould