


T.12S.R5W.W.M.

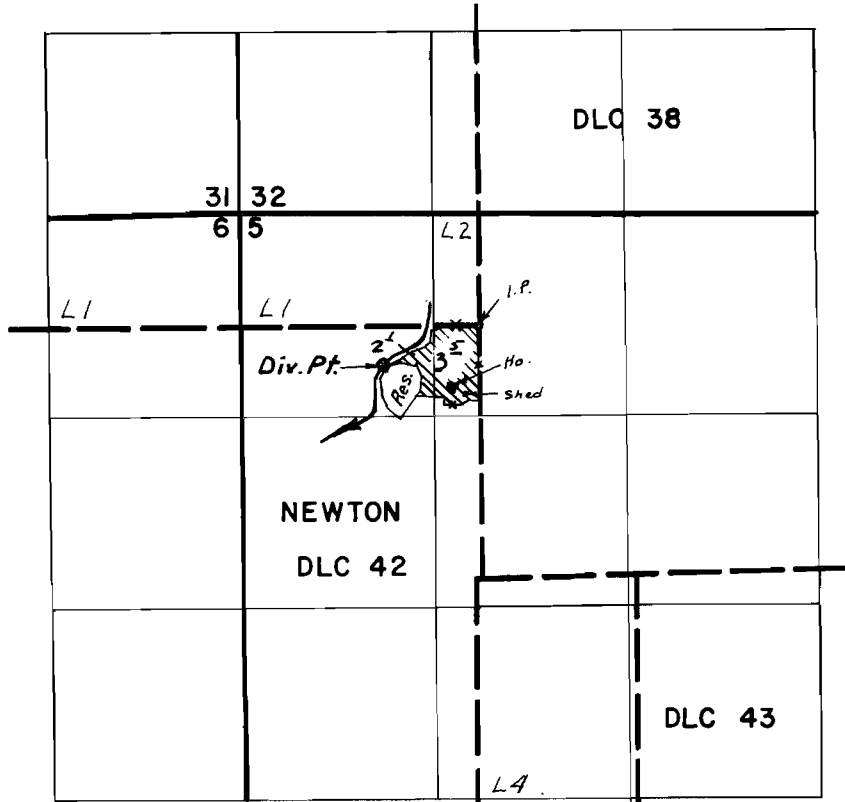

Div. Pt. located: 270 ft. S. & 660 ft. W. from NE cor. Newton DLC 42.

FINAL PROOF SURVEY
UNDER

Application No. R-38080 38081 Permit No. R-3205 28556
IN NAME OF

FRANK G. HORVATH

Surveyed Jul. 2, 1969, by L. E. Gould