


T. 13 S. R. 5 W. W. M

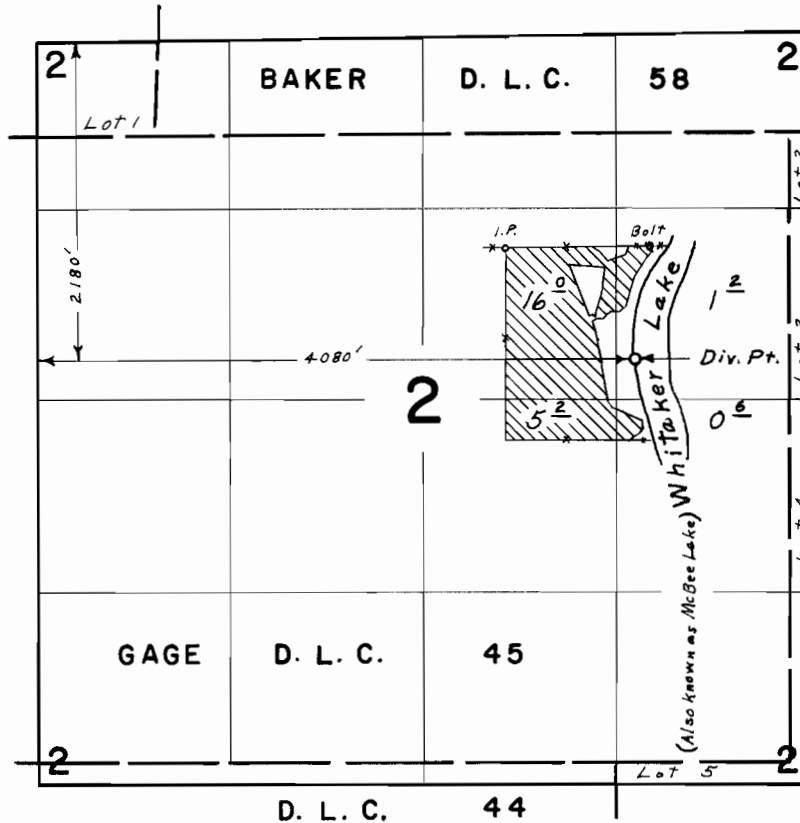

FINAL PROOF SURVEY UNDER

Application No. 43011 Permit No. 32134
IN NAME OF

Robert J. Fry, M.D.

Surveyed Oct. 29, 1969, by L. E. Gould