


T.5S.R.2E.W.M.

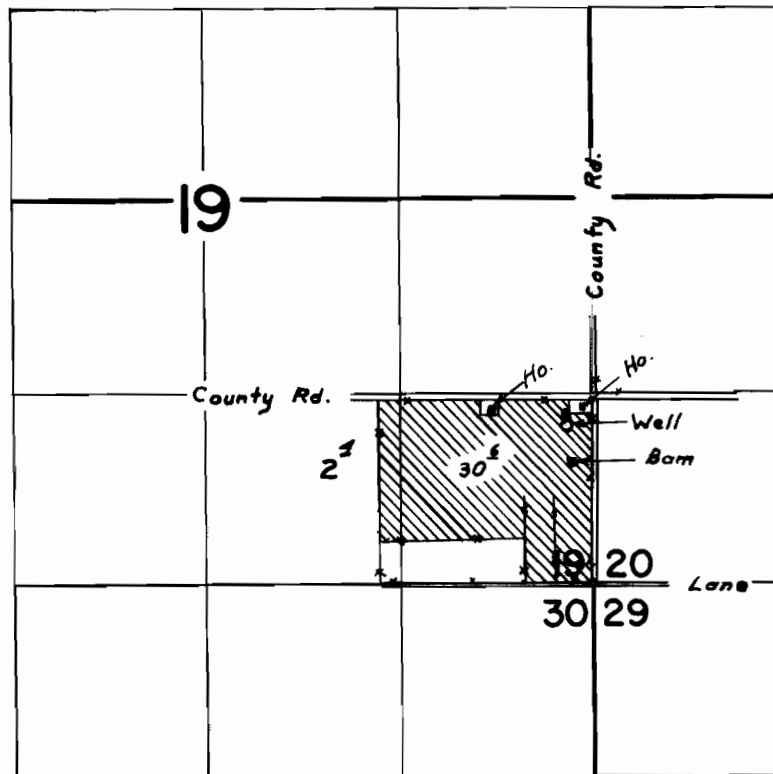

Well located: 1090 ft. N. & 200 ft. W. from SW cor. Sec. 19.

FINAL PROOF SURVEY
UNDER

Application No. G-3920 Permit No. G-3681
IN NAME OF

DELMAR PEASE

Surveyed Nov. 26, 1969, by L. E. Gould