


# T.5S.R.2E.W.M.

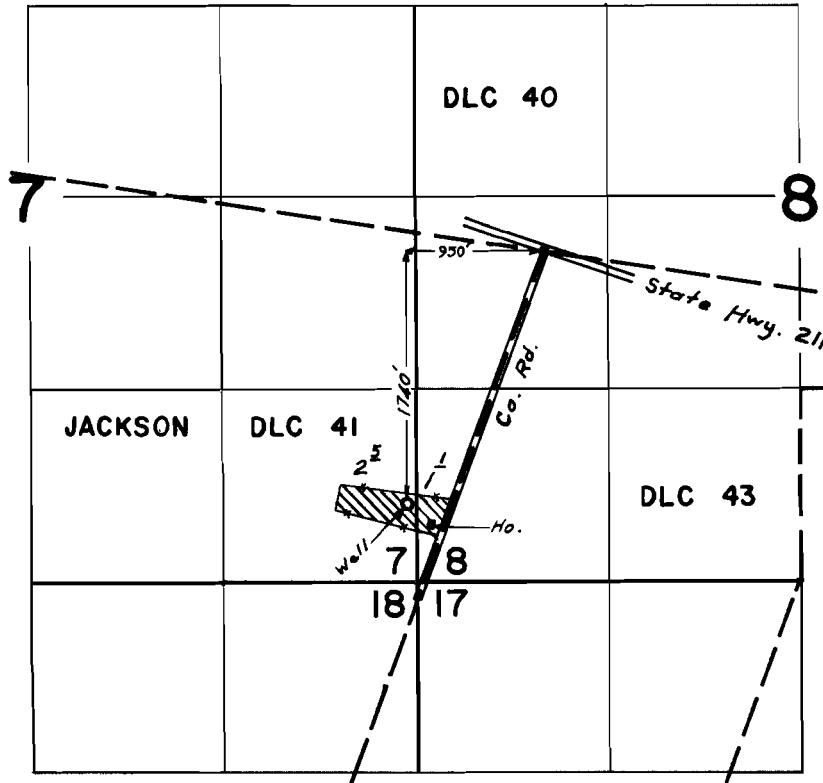

## FINAL PROOF SURVEY UNDER

Application No. G-4341 Permit No. G-4098  
IN NAME OF

ALBERT R. MINERVA

Surveyed Nov. 25, 1969, by L. E. Gould