T.5S.R2E.W.M.

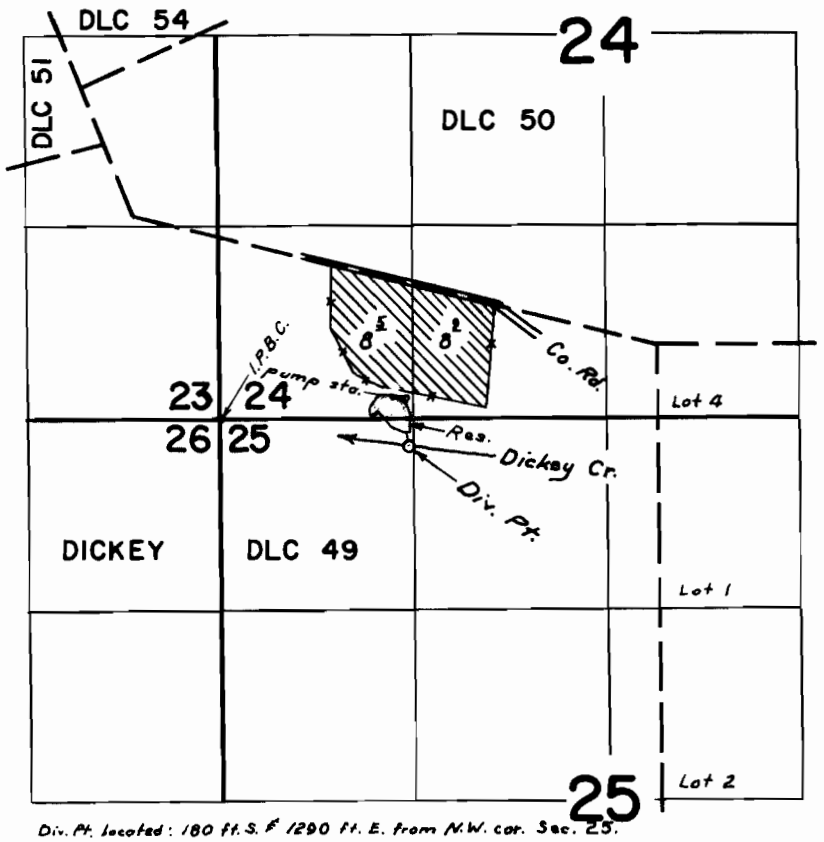

FINAL PROOF SURVEY
UNDER

Application No. R-41705 41706 Permit No. R-4705 31139
IN NAME OF

EDWARD FEYRER

Surveyed Nov. 26 1969, by L. E. Gould

1969-X
R.C.E.