


T.5S.R.3E.W.M.

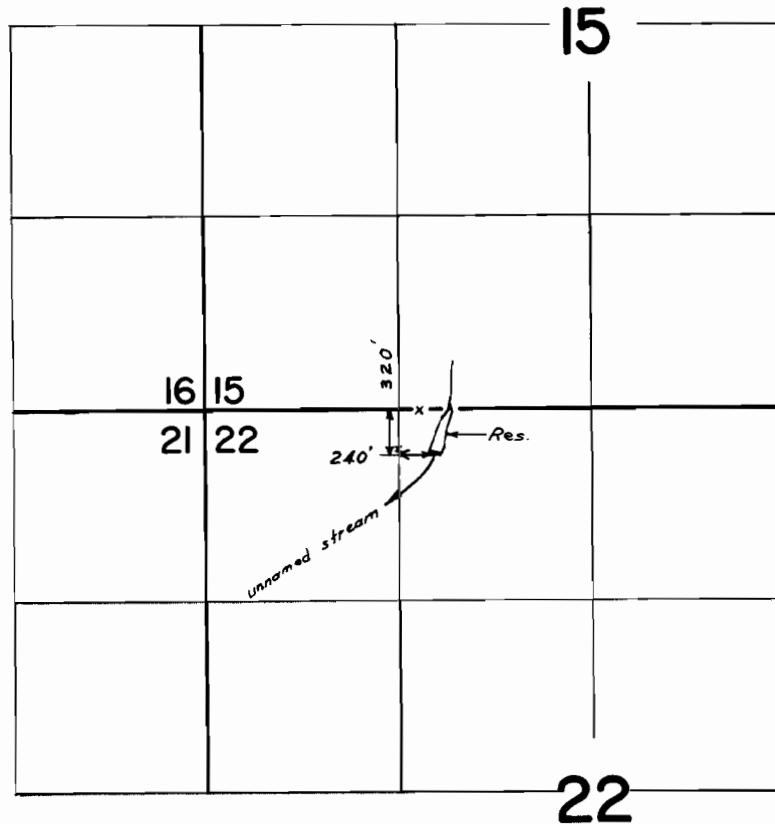

FINAL PROOF SURVEY
UNDER

R-43945 R-5056
Application No. 43946 Permit No. 32834
IN NAME OF
ROLF ODEANE

Surveyed Nov. 21, 1969, by L. E. Gould