


T.5S.R.2E.W.M.

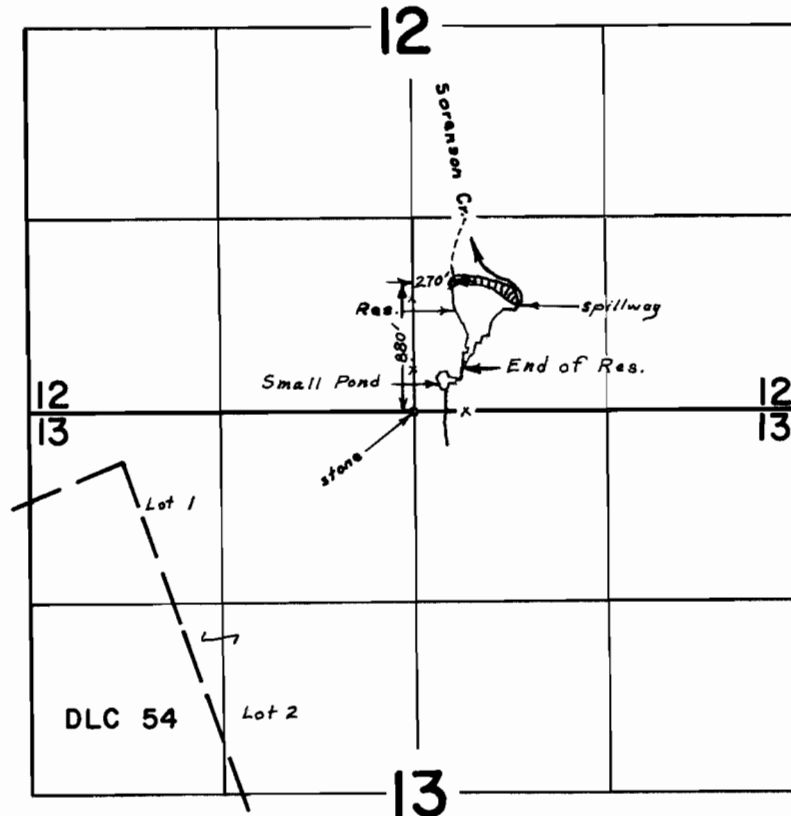

FINAL PROOF SURVEY
UNDER

R-43441 R-5263
Application No. 43459 Permit No. 33288
IN NAME OF

WILLARD G. DEARDORFF

Surveyed Nov. 19 1969, by L. E. Gould