


T.29S.R.14W.W.M.

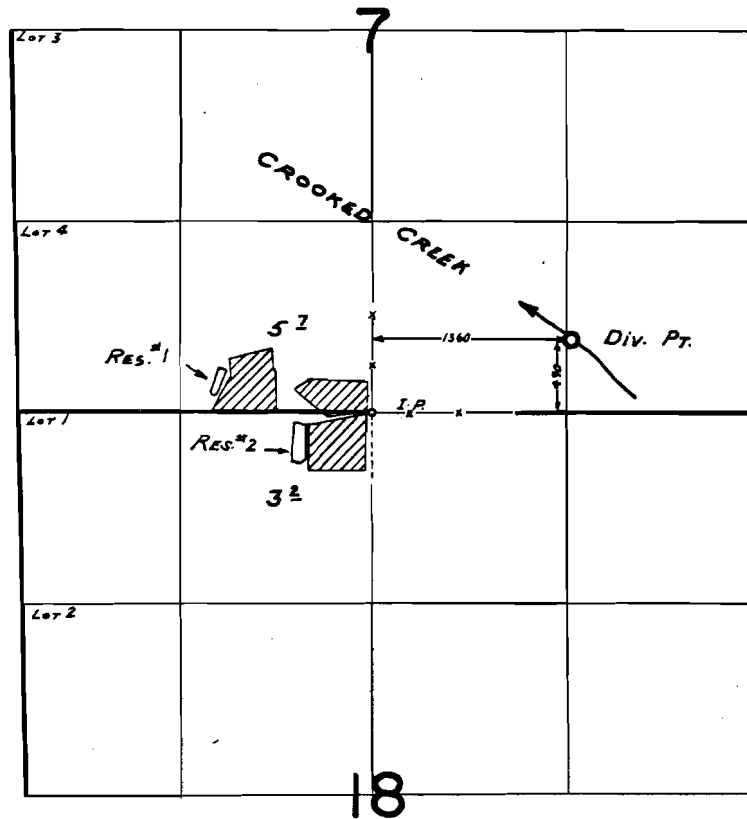

FINAL PROOF SURVEY
UNDER

R-41985

R-4830

Application No. 41986 Permit No. 31786

IN NAME OF

W. R. WARD

Surveyed MAY 16 1969, by W. RUPPERT