T. 35 S. R. 14 W. W. M.

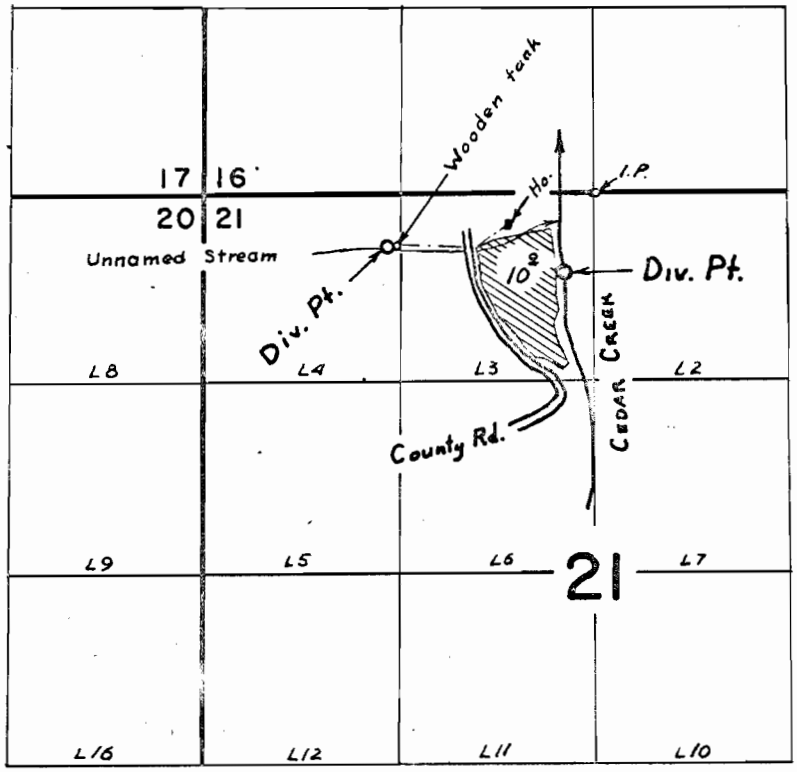

Diversion Points located: 370 ft. S. & 1410 ft. W.; and 540 ft. S. & 210 ft. W.; both from N. ¼ cor. Sec. 21.

FINAL PROOF SURVEY
UNDER

Application No. 39739 (42981) Permit No. 29488 (32112)
IN NAME OF
DOROTHY FERN VINCENT &
ESTATE OF EUGENE MERLE VINCENT

Surveyed May 23 1969, by L. E. Gould

1969-T
ROE