


T. 32 S. R. 15 W. W. M.

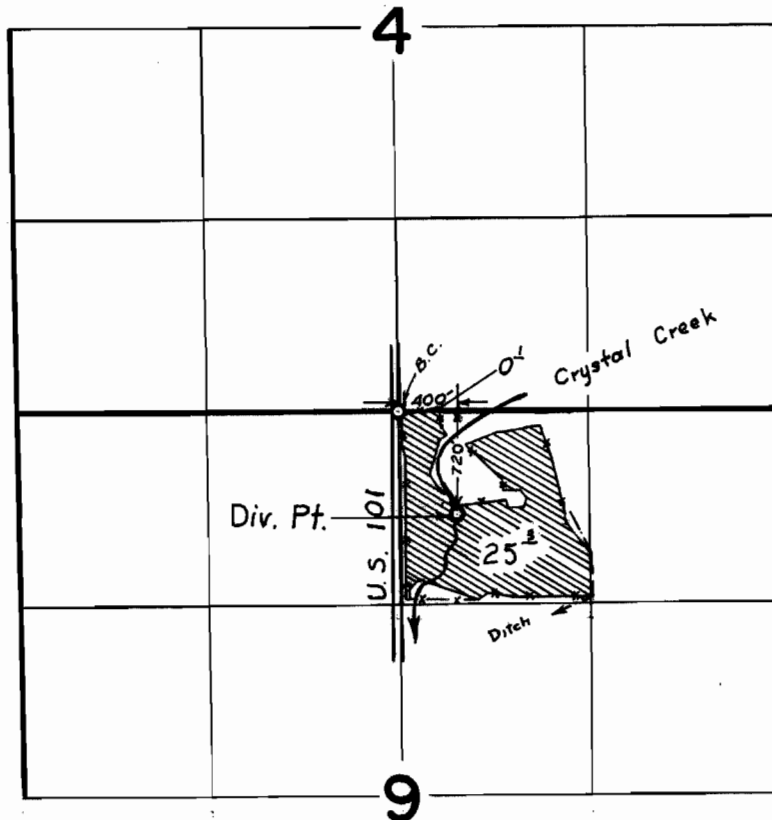

FINAL PROOF SURVEY
UNDER

Application No. 39782... Permit No. 29494
IN NAME OF

HERBERT E. & UILA O. MORRILL

Surveyed May 21, 1969, by L. E. Gould