


T.37S.R.14W.W.M.

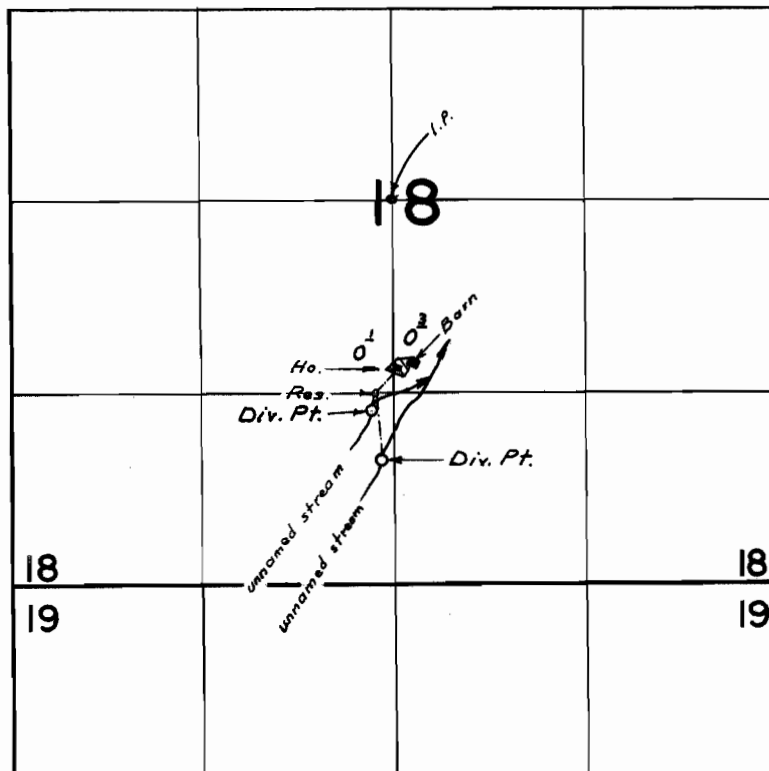

Div. Pt. located: 1440 Ft. S. & 150 Ft. W.; and 1780 Ft. S. & 80 Ft. W.; both from interior $\frac{1}{4}$ cor. Sec. 18.

FINAL PROOF SURVEY
UNDER

Application No. 39801 Permit No. 29496

IN NAME OF
ALLIE M. MYERS &
estate of WALTER L. MYERS

Surveyed Aug. 25, 1969, by L. E. Gould