


T. 32 S. R. 15 W. W. M.

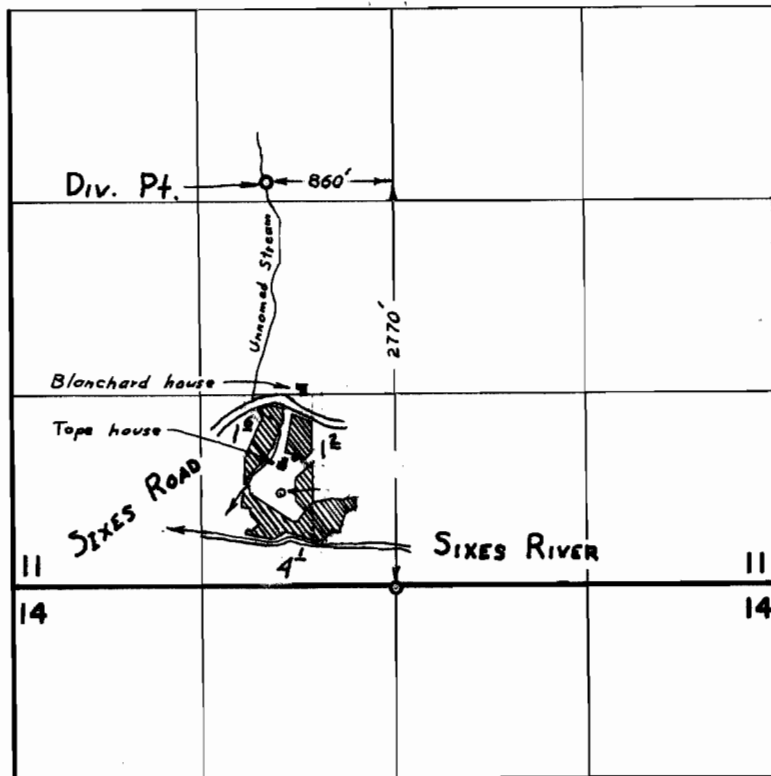

**FINAL PROOF SURVEY**  
UNDER

Application No. 39715... Permit No. 29628...  
IN NAME OF

LaVERNE D. TOPE

Surveyed May 15, 1969, by L. E. Gould