


# T. 35 S. R. 14 W. W.M.

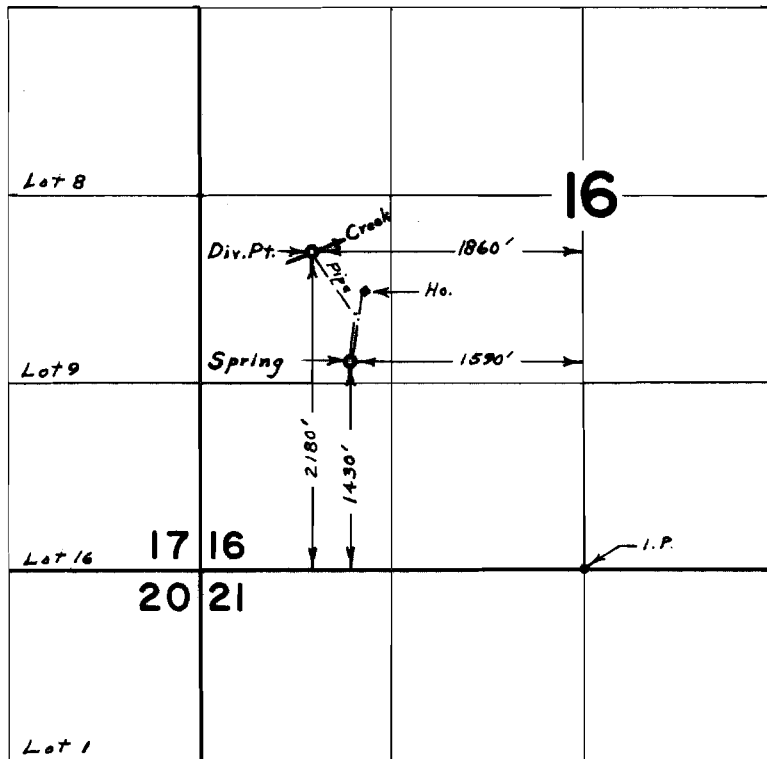

## FINAL PROOF SURVEY UNDER

Application No. 41848 Permit No. 31317.....  
IN NAME OF

**CLYDE L. & LORRAINE M. WINSLOW**

Surveyed Aug. 23, 1969, by L. E. Gould..