


T.32S.R.15W.W.M.

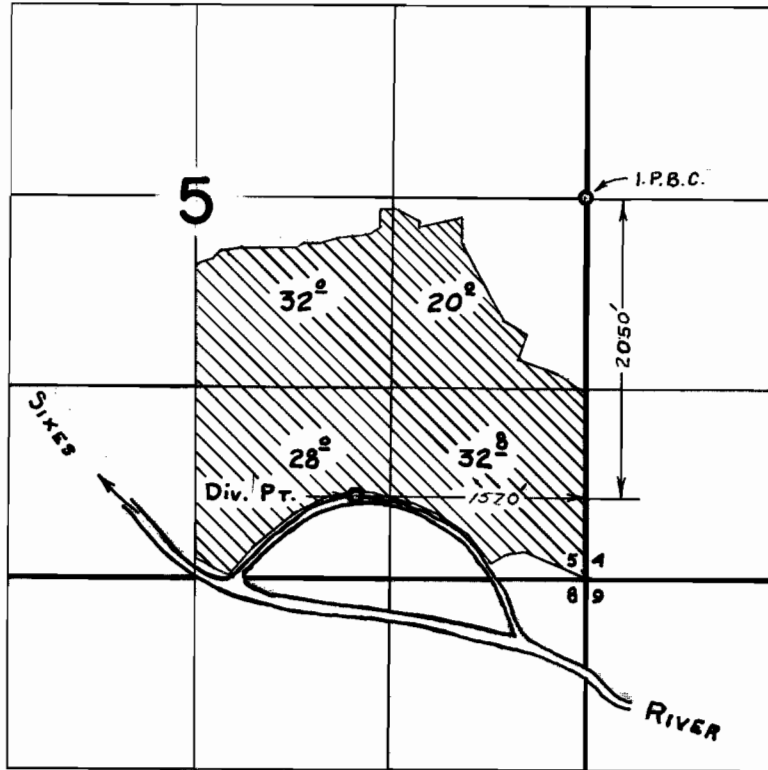

FINAL PROOF SURVEY UNDER

Application No. **42284** Permit No. **31623**
IN NAME OF

JOHN & CLINTON FROMM

Surveyed **May 13, 1969**, by **L. E. Gould**