


T.37S.R.14W.W.M.

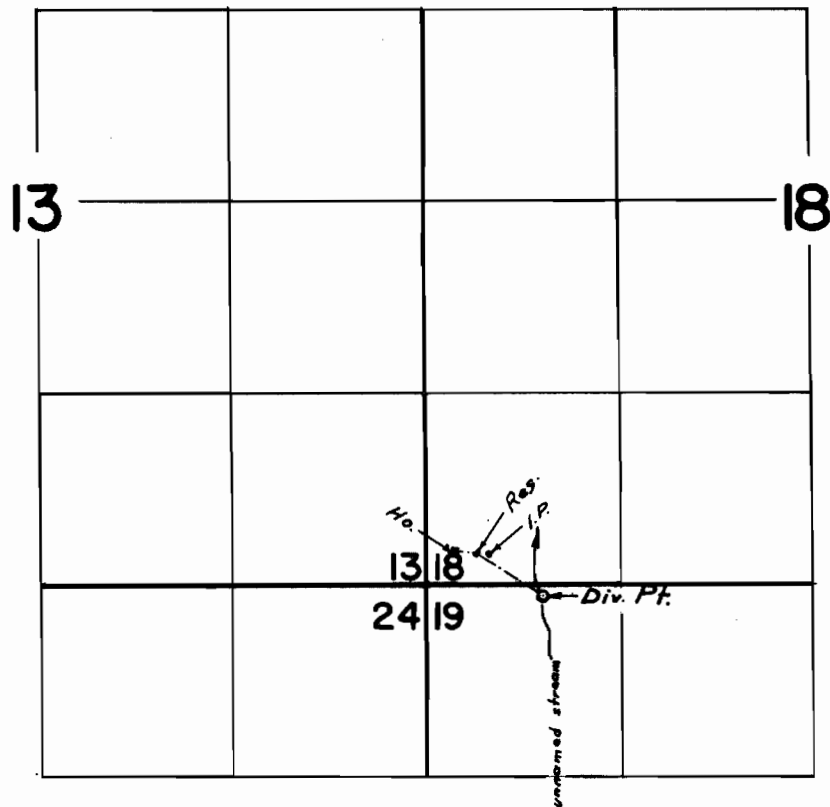

Div. Pt. located: 80 ft. S. & 800 ft. E. from N.W. cor. Sec. 19.

FINAL PROOF SURVEY
UNDER

Application No. 43065 Permit No. 32177
IN NAME OF

LETA O. HARBOUR

Surveyed Aug. 25 1969, by L. E. Gould