


T.40S.R.13W.W.M.

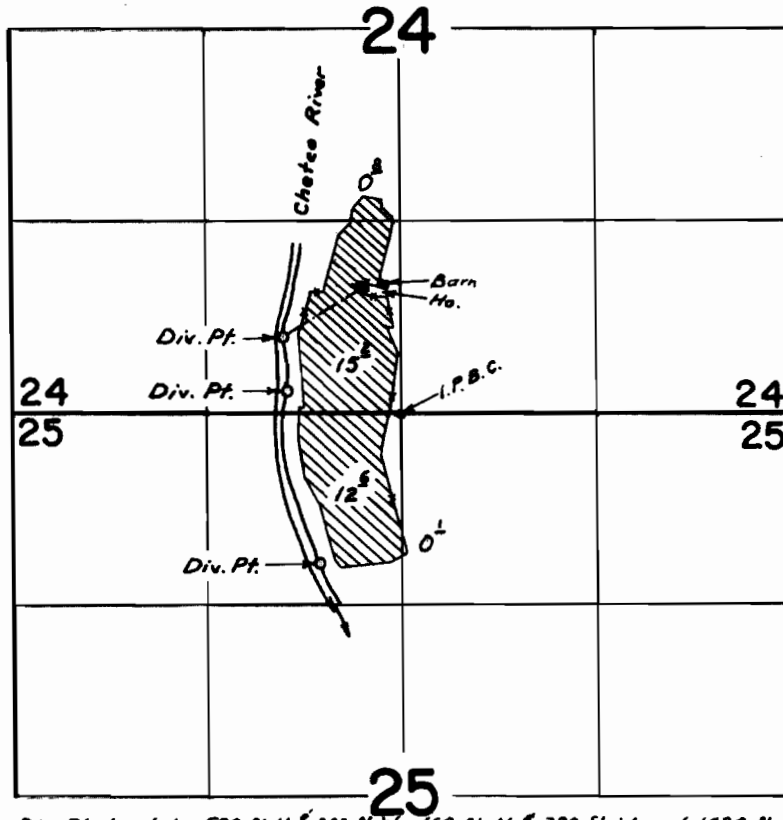

Div. Pts. located: 520 ft. N. of 800 ft. W.; 160 ft. N. of 780 ft. W.; and 1020 ft. S. of 580 ft. W.; all from N. 1/4 cor. Sec. 25.

**FINAL PROOF SURVEY**  
UNDER

Application No. 45249 Permit No. 33281  
IN NAME OF

**THEODORE TAMBA**

Surveyed Sept. 9 1969, by L. E. Gould