


T.27S.R.4W.W.M.

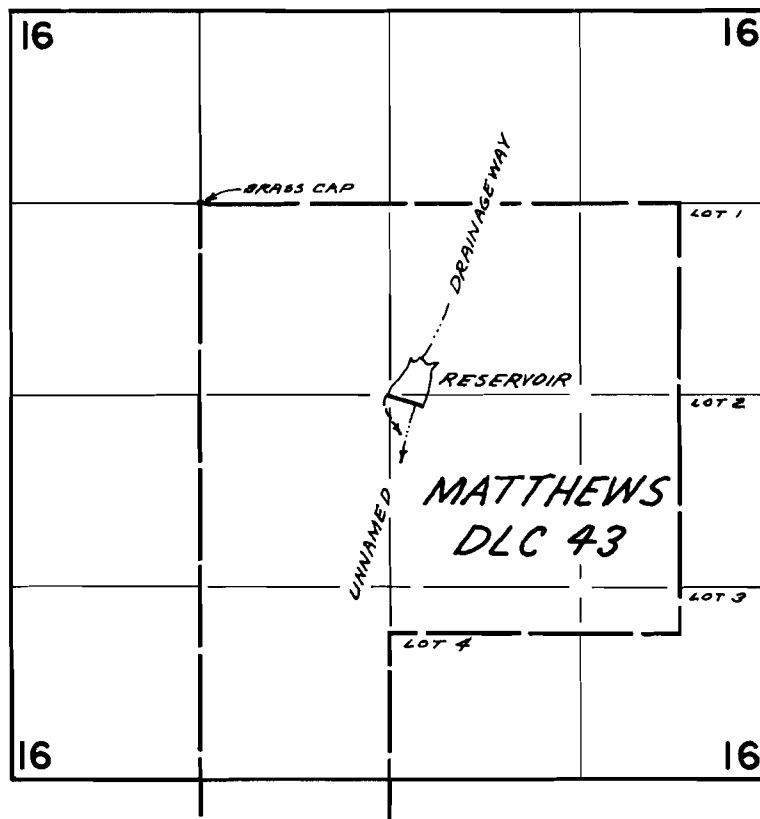

FINAL PROOF SURVEY
UNDER

Application No. R-39189 Permit No. R-3887
IN NAME OF

C. W. COUNTS

Surveyed APR. 17 1969, by W. J. RUPPERT