


T. 32 & 33 S. R. 7 W. W.M.

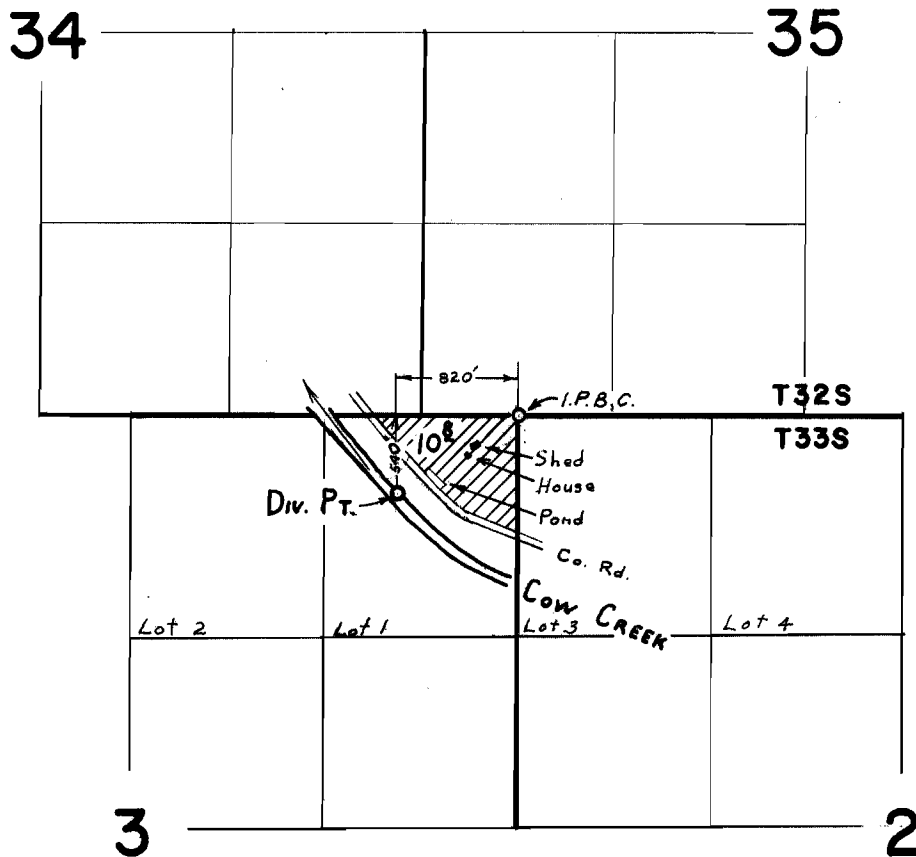

**FINAL PROOF SURVEY**  
UNDER

Application No. 38246 Permit No. 28490  
IN NAME OF

**EVERETT WILLIAM WALTON**

Surveyed MAY 1, 1969, by L. E. GOULD