


T. 24 S. R. 7 W. W. M.

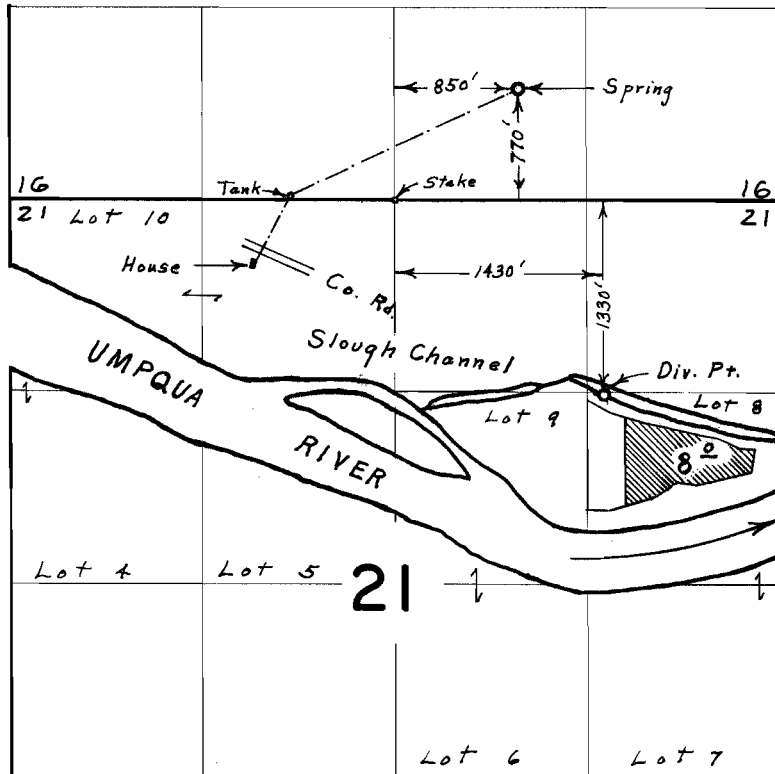

FINAL PROOF SURVEY UNDER

Application No. 41721 Permit No. 31149
IN NAME OF

A. O. KOBBE

Surveyed June 15, 1967, by L. E. Gould