


P 26939
36750

T15S.R.28E.W.M.

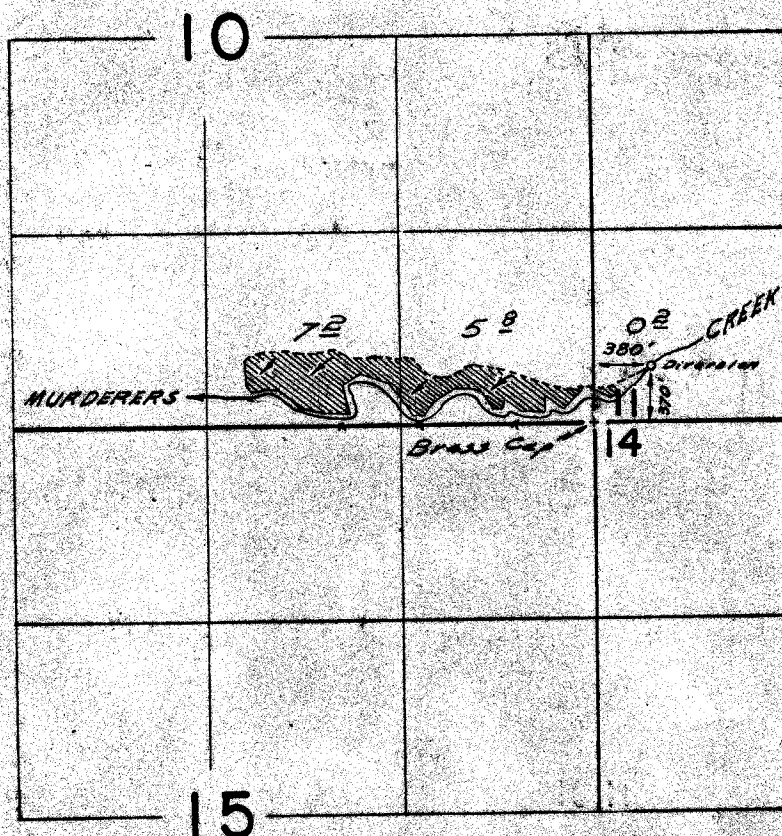

FINAL PROOF SURVEY
UNDER

Application No. 34187 Permit No. 26939
IN NAME OF

WAYNE C. STEWART

Surveyed July 13 1968 by W. Ruppert