


T.14S
R.30E.
W.M.

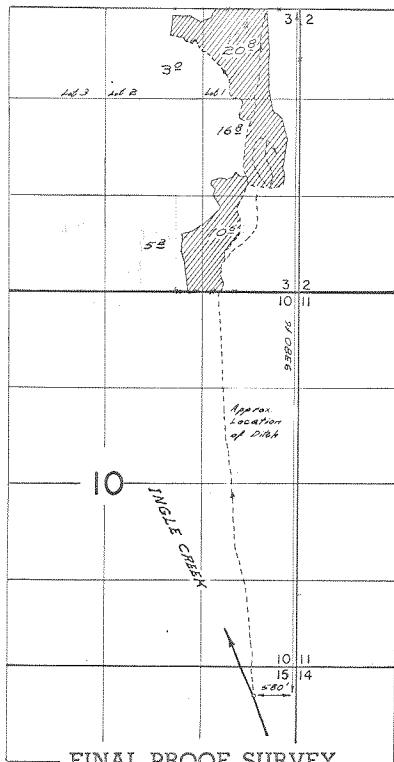

P 28035
36751

Application No. 37563 Permit No. 28035
IN NAME OF

DENNIS F. LEMONS

Surveyed Nov. 13th/1962, by T. Lauer
July 9, 1968 by W.O. Ruppert