P 28269
36752

T.12 S.R.31 E.W.M.

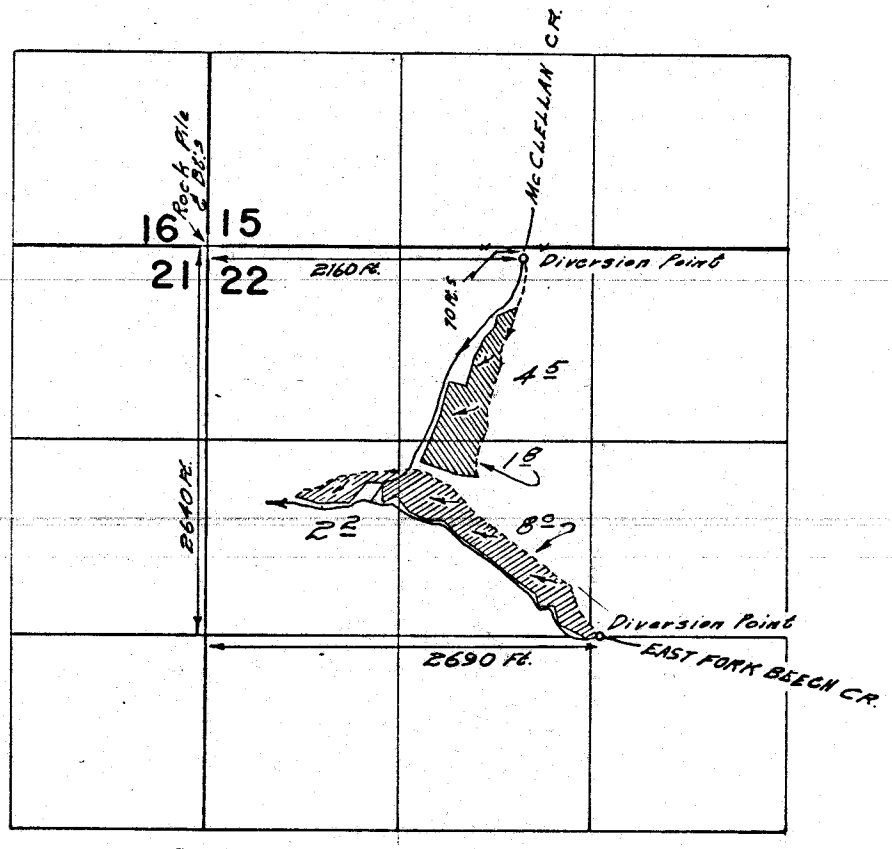

FINAL PROOF SURVEY
UNDER

Application No. 37158 Permit No. 28269
IN NAME OF

R. E. SPROUL

Surveyed July 15 1968, by W. J. Ruppert